

IW-1

WATER WELL PLUGGING RECORD

Form WWC-5P

KSA 82a-1212

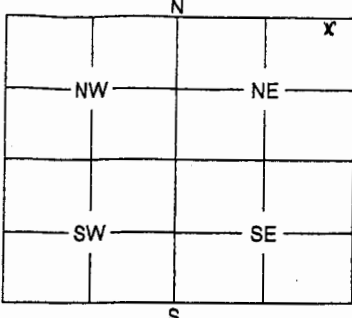
ID NO. 00347358

1	LOCATION OF WATER WELL:	Fraction	Section	Number	Township	Number	Range	Number
	County: <u>Reno</u>	<u>NW 1/4 NE 1/4 NE 1/4</u>	<u>18</u>		<u>23</u>		<u>5</u>	<u>EW</u>

Distance and direction from nearest town or city street address of well if located within city?

1215 E. Fourth Hutchinson KS 67501

2	WATER WELL OWNER: <u>Dick's Enterprises</u>	
	RR #, St. Address, Box #: <u>1215 E. Fourth</u>	Board of Agriculture, Division of Water Resources
	City, State, ZIP Code: <u>Hutchinson KS 67501</u>	Application Number:

3	MARK WELL'S LOCATION WITH AN "X" IN SECTION BOX:	4	DEPTH OF WELL <u>29</u> ft.												
		WELL'S STATIC WATER LEVEL <u>14</u> ft.													
WELL WAS USED AS:															
<table border="0"> <tr> <td>1 Domestic</td> <td>5 Public Water Supply</td> <td>9 Dewatering</td> </tr> <tr> <td>2 Irrigation</td> <td>6 Oil Field Water Supply</td> <td>10 Monitoring Well</td> </tr> <tr> <td>3 Feedlot</td> <td>7 Domestic (Lawn & Garden)</td> <td><u>11</u> Injection Well</td> </tr> <tr> <td>4 Industrial</td> <td>8 Air Conditioning</td> <td>12 Other</td> </tr>
Was a chemical / bacteriological sample submitted to Department? Yes No <u>X</u>															
If yes, mo/day/yr sample was submitted															
Water Well Disinfected: Yes No <u>X</u>															

5	TYPE OF BLANK CASING USED:			
	1 Steel	3 RMP (SR)	5 Wrought	7 Fiberglass
	<u>2</u> PVC	4 ABS	6 Asbestos-Cement	8 Concrete Tile
	9 Other (Specify below)			
	Blank casing diameter <u>2</u> in.	Was casing pulled? Yes <u>X</u> No	If yes, how much <u>3'</u>	
	Casing height above of <u>below</u> and surface <u>32</u> in.			

6	GROUT PLUG MATERIAL: 1 Neat cement 2 Cement grout <u>3</u> Bentonite 4 Other			
	Grout Plug Intervals: From <u>29</u> ft. to <u>3</u> ft., From ft. to ft., From to			
	What is the nearest source of possible contamination:			
	1 Septic tank 2 Sewer lines 3 Watertight sewer lines 4 Lateral lines 5 Cess pool	6 Seepage pit 7 Pit privy 8 Sewage lagoon 9 Feedyard 10 Livestock pens	<u>11</u> Fuel storage 12 Fertilizer storage 13 Insecticide storage 14 Abandoned water well 15 Oil well/Gas well	16 Other (specify below)
	Direction from well? <u>NW</u> How many feet? <u>30</u>			

FROM	TO	PLUGGING MATERIALS
29'	3'	Bentonite chips
3'	0'	Native material

7	CONTRACTOR'S OF LANDOWNER'S CERTIFICATION: This water well was plugged under my jurisdiction and was completed on (mo/day/year) <u>7-21-09</u> and this record is true to the best of my knowledge and belief. Kansas Water Well Contractor's License No. <u>8-11-09</u> This Water Well Record was completed on (mo/day/year) <u>8-11-09</u> under the business name of <u>Green Field Contractors</u>	
	by (signature) <u>Jan Pearson</u>	

INSTRUCTIONS: Use typewriter or ball point pen. Please press firmly and print clearly. Please fill in blanks, underline or circle the correct answers. Send top three copies to Kansas Department of Health and Environment, Bureau of Water, Geology Section, 1000 SW Jackson St. Ste 420 Topeka Kansas 66612-1367. Telephone: 785/296-5522. Send one to Water Well Owner and retain one for your records.