

IW-2

WATER WELL PLUGGING RECORD

Form WWC-5P

KSA 82a-1212

ID NO. 00347365

1	LOCATION OF WATER WELL:	Fraction	Section	Number	Township	Number	Range	Number
	County: <u>Reno</u>	<u>NW 1/4 NE 1/4 NE 1/4 NE</u>	<u>18</u>		<u>23</u>		<u>5</u>	<u>EW</u>

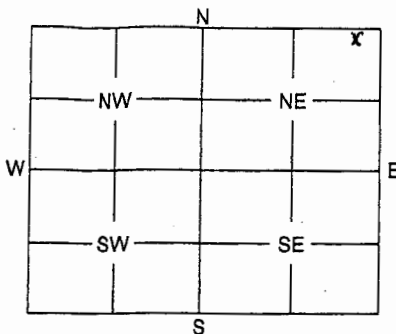
Distance and direction from nearest town or city street address of well if located within city?

1215 E. Fourth Hutchinson KS 675012 WATER WELL OWNER: Dick's EnterprisesRR #, St. Address, Box #: 1215 E. FourthCity, State, ZIP Code: Hutchinson KS 67501

Board of Agriculture, Division of Water Resources

Application Number:

3 MARK WELL'S LOCATION WITH AN "X" IN SECTION BOX:

4 DEPTH OF WELL 29 ft.WELL'S STATIC WATER LEVEL 14 ft.

WELL WAS USED AS:

- |              |                            |                          |
|--------------|----------------------------|--------------------------|
| 1 Domestic   | 5 Public Water Supply      | 9 Dewatering             |
| 2 Irrigation | 6 Oil Field Water Supply   | 10 Monitoring Well       |
| 3 Feedlot    | 7 Domestic (Lawn & Garden) | <u>11</u> Injection Well |
| 4 Industrial | 8 Air Conditioning         | 12 Other .....           |

Was a chemical / bacteriological sample submitted to Department? Yes ..... No X.....  
If yes, mo/day/yr sample was submitted .....Water Well Disinfected: Yes ..... No X.....

5 TYPE OF BLANK CASING USED:

- |              |            |                   |                 |                         |
|--------------|------------|-------------------|-----------------|-------------------------|
| 1 Steel      | 3 RMP (SR) | 5 Wrought         | 7 Fiberglass    | 9 Other (Specify below) |
| <u>2</u> PVC | 4 ABS      | 6 Asbestos-Cement | 8 Concrete Tile |                         |

Blank casing diameter 2 in. Was casing pulled? Yes X..... No ..... If yes, how much 3'  
Casing height above or below land surface 36 in.6 GROUT PLUG MATERIAL: 1 Neat cement 2 Cement grout 3 Bentonite 4 Other .....  
Grout Plug Intervals: From 29 ft. to 3 ft., From ..... ft. to ..... ft., From ..... to ..... ft.

What is the nearest source of possible contamination:

- |                          |                   |                         |                          |
|--------------------------|-------------------|-------------------------|--------------------------|
| 1 Septic tank            | 6 Seepage pit     | <u>11</u> Fuel storage  | 16 Other (specify below) |
| 2 Sewer lines            | 7 Pit privy       | 12 Fertilizer storage   |                          |
| 3 Watertight sewer lines | 8 Sewage lagoon   | 13 Insecticide storage  |                          |
| 4 Lateral lines          | 9 Feedyard        | 14 Abandoned water well |                          |
| 5 Cess pool              | 10 Livestock pens | 15 Oil well/Gas well    |                          |

Direction from well? W How many feet? 50

FROM	TO	PLUGGING MATERIALS
29'	3'	Bentonite chips
3'	0'	Native material

7 CONTRACTOR'S OF LANDOWNER'S CERTIFICATION: This water well was plugged under my jurisdiction and was completed on (mo/day/year) 7-21-09 and this record is true to the best of my knowledge and belief. Kansas Water Well Contractor's License No. .... This Water Well Record was completed on (mo/day/year) 8-11-09 under the business name of GreenField Contractors by (signature) Jan P. ...

INSTRUCTIONS: Use typewriter or ball point pen. Please press firmly and print clearly. Please fill in blanks, underline or circle the correct answers. Send top three copies to Kansas Department of Health and Environment, Bureau of Water, Geology Section, 1000 SW Jackson St. Ste. 420 Topeka, Kansas 66612-1367 Telephone: 785/296-5522. Send one to Water Well Owner and retain one for your records.