

VE-1

WATER WELL PLUGGING RECORD

Form WWC-5P

KSA 82a-1212

ID NO. 00347334

1	LOCATION OF WATER WELL:	Fraction	Section Number	Township Number	Range Number
	County: <u>Reno</u>	<u>NW 1/4 NE 1/4 NE 1/4 NE</u>	<u>18</u>	<u>23</u>	<u>5</u> <u>EW</u>

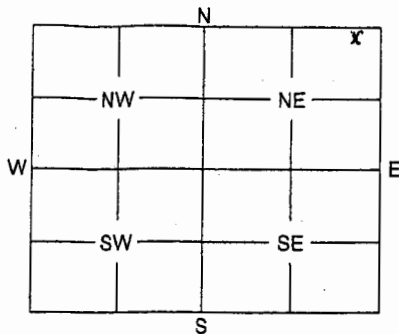
Distance and direction from nearest town or city street address of well if located within city?

1215 E. Fourth Hutchinson KS 675012 WATER WELL OWNER: Dick's EnterprisesRR #, St. Address, Box #: 1215 E. FourthCity, State, ZIP Code: Hutchinson KS 67501

Board of Agriculture, Division of Water Resources

Application Number:

3 MARK WELL'S LOCATION WITH AN "X" IN SECTION BOX:

4 DEPTH OF WELL 17 ft.WELL'S STATIC WATER LEVEL 14 ft.

WELL WAS USED AS:

1 Domestic

2 Irrigation

3 Feedlot

4 Industrial

5 Public Water Supply

6 Oil Field Water Supply

7 Domestic (Lawn & Garden)

8 Air Conditioning

9 Dewatering

10 Monitoring Well

11 Injection Well

12 Other SUEWas a chemical / bacteriological sample submitted to Department? Yes No X.....

If yes, mo/day/yr sample was submitted

Water Well Disinfected: Yes No X.....

5 TYPE OF BLANK CASING USED:

1 Steel

3 RMP (SR)

5 Wrought

7 Fiberglass

9 Other (Specify below)

2 PVC

4 ABS

6 Asbestos-Cement

8 Concrete Tile

Blank casing diameter 4 in.Was casing pulled? Yes X..... NoIf yes, how much 3'.....Casing height above or below land surface 36 in.

6 GROUT PLUG MATERIAL:

1 Neat cement

2 Cement grout

3 Bentonite

4 Other

Grout Plug Intervals:

From 17 ft.to 3 ft.,

From ft. to ft.,

From to ft.

What is the nearest source of possible contamination:

1 Septic tank

2 Sewer lines

3 Watertight sewer lines

4 Lateral lines

5 Cess pool

6 Seepage pit

7 Pit privy

8 Sewage lagoon

9 Feedyard

10 Livestock pens

11 Fuel storage

12 Fertilizer storage

13 Insecticide storage

14 Abandoned water well

15 Oil well/Gas well

16 Other (specify below)

Direction from well? NW.....How many feet? 35.....

FROM	TO	PLUGGING MATERIALS
<u>17'</u>	<u>3'</u>	<u>Bentonite chips</u>
<u>3'</u>	<u>0'</u>	<u>Native material</u>

7 CONTRACTOR'S OF LANDOWNER'S CERTIFICATION: This water well was plugged under my jurisdiction and was completed on (mo/day/year) 7-21-09 and this record is true to the best of my knowledge and belief. Kansas Water Well Contractor's License No. This Water Well Record was completed on (mo/day/year) 8-11-09 under the business name of GreenField Contractors by (signature) Jan Pearson

INSTRUCTIONS: Use typewriter or ball point pen. Please press firmly and print clearly. Please fill in blanks, underline or circle the correct answers. Send top three copies to Kansas Department of Health and Environment, Bureau of Water, Geology Section, 1000 SW Jackson St. Ste. 420 Topeka, Kansas 66612-1367. Telephone: 785/296-5522. Send one to Water Well Owner and retain one for your records.