

WATER WELL PLUGGING RECORD Form WWC-5P

KSA 82a-1212

ID NO.

RN-20

1 LOCATION OF WATER WELL: County: <u>Reno</u>	Fraction <u>1/4 S2 1/4 N2 1/4 NW 1/4</u>	Section Number <u>19</u>	Township Number <u>T 23 S</u>	Range Number <u>5</u> <input type="checkbox"/> E <input checked="" type="checkbox"/> W
--	---	-----------------------------	----------------------------------	---

Street/Rural Address of Well Location; if unknown, distance & direction from nearest town or intersection: If at owner's address, check here ☐ Cleveland and Campbell Street

Hutchinson, Ks.

Global Positioning Systems (GPS) information:

Latitude: _____ (in decimal degrees)

Longitude: _____ (in decimal degrees)

Elevation: _____

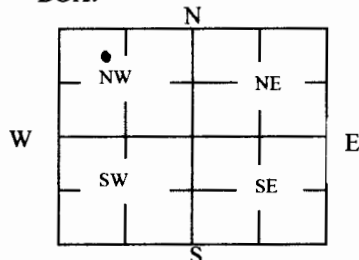
Datum: ☐ WGS84, ☐ NAD83, ☐ NAD27

Collection Method: _____

☐ GPS unit (Make/Model: _____)☐ Digital Map/Photo, ☐ Topographic Map, ☐ Land SurveyEst. Accuracy: ☐ < 3 m, ☐ 3-5 m, ☐ 5-15 m, ☐ > 15 m

2 WATER WELL OWNER: Cargill Inc.
RR#, St. Address, Box #: P.O. Box 1403
City, State ZIP Code: Hutchinson, Ks. 67504

3 MARK WELL'S LOCATION WITH AN "X" IN SECTION BOX:

4 DEPTH OF WELL 70 ft.WELL'S STATIC WATER LEVEL 21 ft

WELL WAS USED AS:

☐ Domestic
☐ Irrigation
☐ Feedlot
☒ Industrial

☐ Public Water Supply
☐ Oil Field Water Supply
☐ Domestic (Lawn & Garden)
☐ Air Conditioning

☐ Dewatering
☐ Monitoring
☐ Injection Well
☐ Other _____

Was a chemical/bacteriological sample submitted to Department? Yes ☐ No ☒

5 TYPE OF BLANK CASING USED:

☒ Steel
☐ PVC☐ RMP (SR)
☐ ABS☐ Wrought
☐ Asbestos-Cement☐ Fiberglass
☐ Concrete Tile☐ Other (Specify below) _____

Blank casing diameter 16 in. Was casing pulled? Yes ☐ No ☒ If yes, how much _____
Casing height above or below land surface 36 in.

6 GROUT PLUG MATERIAL:



Neat cement



Cement grout



Bentonite

Other sandGrout Plug Intervals: From 70 ft. to 21 ft., From 21 ft. to 3 ft., From 3 to 0 ft.

What is the nearest source of possible contamination:

☐ Septic tank☐ Sewer lines☐ Watertight sewer lines☐ Lateral lines☐ Cess pool☐ Seepage pit☐ Pit privy☐ Sewage lagoon☐ Feedyard☐ Livestock pens☐ Fuel Storage☐ Fertilizer storage☐ Insecticide storage☐ Abandoned water well☐ Oil well/Gas well☒ Other (specify below)

Industrial Well

Direction from well? EastHow many feet? 25'

FROM	TO	PLUGGING MATERIALS	FROM	TO	PLUGGING MATERIALS
0	3	Neat cement			
3	21	Benonite			
21	70	Sand			

7 CONTRACTOR'S OR LANDOWNER'S CERTIFICATION:

This water well was plugged under my jurisdiction and was completed on (mo/day/year) 7-16-2012 and this record is true to the best of my knowledge and belief. Kansas WaterWell Contractor's License No. 134. This Water Well Record was completed on (mo/day/year) 7-20-2012 under thebusiness name of Rosencrantz-Bemis Ent. by (signature) [Signature]

INSTRUCTIONS: Use typewriter or ballpoint pen. Please press firmly and print clearly. Please fill in blanks, underline or circle the correct answers. Send top three copies to Kansas Department of Health and Environment, Bureau of Water, Geology Section, 1000 SW Jackson St., Ste. 420, Topeka, Kansas 66612-1367. Telephone: 785/296-5524. Send one to Water Well Owner and retain one for your records. Visit us at <http://www.kdheks.gov/waterwell/index.html>.

Check one:

☒ White Copy☐ Blue Copy☐ Pink Copy