

WATER WELL PLUGGING RECORD Form WWC-5P
KSA 82a-1212
ID NO.
FNE-SVE2

1 LOCATION OF WATER WELL: County: <u>Reno</u>	Fraction <u>¼ sw ¼ ne ¼ sw ¼</u>	Section Number <u>09</u>	Township Number <u>T 23 S</u>	Range Number <u>5</u> <input type="checkbox"/> E <input checked="" type="checkbox"/> W
---------------------------------------------------------	-------------------------------------	-----------------------------	----------------------------------	-------------------------------------------------------------------------------------------

Street/Rural Address of Well Location; if unknown, distance & direction from nearest town or intersection: If at owner's address, check here ☐ ADM Elevator J
816 N. Halstead St.
Hutchinson, KS 67501

Global Positioning Systems (GPS) information:

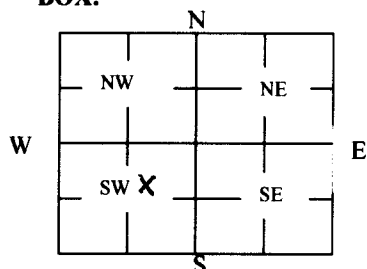
Latitude: 38.062188 (in decimal degrees)
Longitude: -97.878439 (in decimal degrees)
Elevation: 1527.0

Horizontal Datum: ☐ WGS84, ☒ NAD83, ☐ NAD27
Collection Method:

2 WATER WELL OWNER: City of Hutchinson
RR#, St. Address, Box #: PO Box 1567
City, State ZIP Code: Hutchinson, KS 67504-1567

☒ GPS unit (Make/Model: Topcon GRS-1)
☐ Digital Map/Photo, ☐ Topographic Map, ☐ Land Survey

Est. Accuracy: ☒ < 3 m, ☐ 3-5 m, ☐ 5-15 m, ☐ > 15 m

3 MARK WELL'S LOCATION WITH AN "X" IN SECTION BOX:

4 DEPTH OF WELL 14 ft.

WELL'S STATIC WATER LEVEL dry ft

WELL WAS USED AS:

- | | | |
|-------------------------------------|---------------------------------------------------|------------------------------------------------------------------|
| <input type="checkbox"/> Domestic | <input type="checkbox"/> Public Water Supply | <input type="checkbox"/> Dewatering |
| <input type="checkbox"/> Irrigation | <input type="checkbox"/> Oil Field Water Supply | <input type="checkbox"/> Monitoring |
| <input type="checkbox"/> Feedlot | <input type="checkbox"/> Domestic (Lawn & Garden) | <input checked="" type="checkbox"/> Injection Well |
| <input type="checkbox"/> Industrial | <input type="checkbox"/> Air Conditioning | <input checked="" type="checkbox"/> Other <u>soil vapor ext.</u> |

Was a chemical/bacteriological sample submitted to Department? Yes ☐ No ☒

5 TYPE OF BLANK CASING USED:

- ☐ Steel ☐ RMP (SR) ☐ Wrought ☐ Fiberglass ☐ Other (Specify below)
☒ PVC ☐ ABS ☐ Asbestos-Cement ☐ Concrete Tile

Blank casing diameter 4 in. Was casing pulled? Yes ☐ No ☒ If yes, how much _____
Casing height above or below land surface 48 below in.

6 GROUT PLUG MATERIAL: ☐ Neat cement ☐ Cement grout ☒ Bentonite ☐ Other _____

Grout Plug Intervals: From 14 ft. to 4 ft., From _____ ft. to _____ ft., From _____ ft. to _____ ft.

What is the nearest source of possible contamination:

- | | | | |
|-------------------------------------------------|-----------------------------------------|-----------------------------------------------|-----------------------------------------------------------|
| <input type="checkbox"/> Septic tank | <input type="checkbox"/> Seepage pit | <input type="checkbox"/> Fuel storage | <input checked="" type="checkbox"/> Other (specify below) |
| <input type="checkbox"/> Sewer lines | <input type="checkbox"/> Pit privy | <input type="checkbox"/> Fertilizer storage | <u>Carbon-Tetrachloride Remediation Site</u> |
| <input type="checkbox"/> Watertight sewer lines | <input type="checkbox"/> Sewage lagoon | <input type="checkbox"/> Insecticide storage | |
| <input type="checkbox"/> Lateral lines | <input type="checkbox"/> Feedyard | <input type="checkbox"/> Abandoned water well | Direction from well? <u>at well site</u> |
| <input type="checkbox"/> Cess pool | <input type="checkbox"/> Livestock pens | <input type="checkbox"/> Oil well/Gas well | How many feet? <u>0</u> |

FROM	TO	PLUGGING MATERIALS	FROM	TO	PLUGGING MATERIALS
14	4	Bentonite Holeplug			
4	0	Topsoil			Former 4th & Carey Source Area
					Remediation Project Well.

7 CONTRACTOR'S OR LANDOWNER'S CERTIFICATION: This water well was plugged under my jurisdiction and was completed on (mo/day/year) 10/28/2015 and this record is true to the best of my knowledge and belief. Kansas Water Well Contractor's License No. n/a. This Water Well Record was completed on (mo/day/year) 11/17/2015 under the business name of City of Hutchinson, KS by (signature) Donald Koci P.G.

Send one white copy to Kansas Department of Health & Environment, Geology Section, 1000 SW Jackson Street, Ste. 420, Topeka, KS 66612-1367. Send one copy to WATER WELL OWNER and retain one for your records.

Visit us at <http://www.kdheks.gov/waterwell/index.html> Telephone 785-296-5524.

KSA82a-1212
Revised 1/20/2015