

WATER WELL PLUGGING RECORD Form WWC-5P

KSA 82a-1212

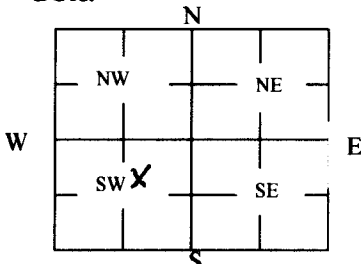
ID NO.

CMW-302S

1 LOCATION OF WATER WELL: County: Reno	Fraction ¼ sw ¼ ne ¼ sw ¼	Section Number 09	Township Number T 23 S	Range Number 5 ☐ E ☒ W
--	------------------------------	----------------------	---------------------------	--

Street/Rural Address of Well Location; if unknown, distance & direction from nearest town or intersection: If at owner's address, check here ☐ ADM Elevator J 816 N. Halstead St. Hutchinson, KS 67501	Global Positioning Systems (GPS) information: Latitude: 38.062527 (in decimal degrees) Longitude: -97.879455 (in decimal degrees) Elevation: 1528 Horizontal Datum: ☐ WGS84, ☒ NAD83, ☐ NAD27 Collection Method: ☒ GPS unit (Make/Model: Topcon GRS-1) ☐ Digital Map/Photo, ☐ Topographic Map, ☐ Land Survey Est. Accuracy: ☒ < 3 m, ☐ 3-5 m, ☐ 5-15 m, ☐ > 15 m
---	---

2 WATER WELL OWNER: City of Hutchinson RR#, St. Address, Box #: PO Box 1567 City, State ZIP Code: Hutchinson, KS 67504-1567	
--	--

3 MARK WELL'S LOCATION WITH AN "X" IN SECTION BOX: 	4 DEPTH OF WELL 24.6 ft. WELL'S STATIC WATER LEVEL 16.74 ft. WELL WAS USED AS: <table border="0"> <tr> <td>☐ Domestic</td> <td>☐ Public Water Supply</td> <td>☐ Dewatering</td> </tr> <tr> <td>☐ Irrigation</td> <td>☐ Oil Field Water Supply</td> <td>☒ Monitoring</td> </tr> <tr> <td>☐ Feedlot</td> <td>☐ Domestic (Lawn & Garden)</td> <td>☐ Injection Well</td> </tr> <tr> <td>☐ Industrial</td> <td>☐ Air Conditioning</td> <td>☐ Other</td> </tr> </table> Was a chemical/bacteriological sample submitted to Department? Yes ☐ No ☒	☐ Domestic	☐ Public Water Supply	☐ Dewatering	☐ Irrigation	☐ Oil Field Water Supply	☒ Monitoring	☐ Feedlot	☐ Domestic (Lawn & Garden)	☐ Injection Well	☐ Industrial	☐ Air Conditioning	☐ Other
☐ Domestic	☐ Public Water Supply	☐ Dewatering											
☐ Irrigation	☐ Oil Field Water Supply	☒ Monitoring											
☐ Feedlot	☐ Domestic (Lawn & Garden)	☐ Injection Well											
☐ Industrial	☐ Air Conditioning	☐ Other											

5 TYPE OF BLANK CASING USED: ☐ Steel ☐ RMP (SR) ☐ Wrought ☐ Fiberglass ☐ Other (Specify below) ☒ PVC ☐ ABS ☐ Asbestos-Cement ☐ Concrete Tile
Blank casing diameter 1 in. Was casing pulled? Yes ☒ No ☐ If yes, how much All Casing height above or below land surface n/a in.

6 GROUT PLUG MATERIAL: ☐ Neat cement ☐ Cement grout ☒ Bentonite ☐ Other																				
Grout Plug Intervals: From 24.6 ft. to 3 ft., From ft. to ft., From ft. to ft.																				
What is the nearest source of possible contamination: <table border="0"> <tr> <td>☐ Septic tank</td> <td>☐ Seepage pit</td> <td>☐ Fuel storage</td> <td>☒ Other (specify below)</td> </tr> <tr> <td>☐ Sewer lines</td> <td>☐ Pit privy</td> <td>☐ Fertilizer storage</td> <td>Carbon-Tetrachloride Remediation Site</td> </tr> <tr> <td>☐ Watertight sewer lines</td> <td>☐ Sewage lagoon</td> <td>☐ Insecticide storage</td> <td></td> </tr> <tr> <td>☐ Lateral lines</td> <td>☐ Feedyard</td> <td>☐ Abandoned water well</td> <td>Direction from well? at well site</td> </tr> <tr> <td>☐ Cess pool</td> <td>☐ Livestock pens</td> <td>☐ Oil well/Gas well</td> <td>How many feet? 0</td> </tr> </table>	☐ Septic tank	☐ Seepage pit	☐ Fuel storage	☒ Other (specify below)	☐ Sewer lines	☐ Pit privy	☐ Fertilizer storage	Carbon-Tetrachloride Remediation Site	☐ Watertight sewer lines	☐ Sewage lagoon	☐ Insecticide storage		☐ Lateral lines	☐ Feedyard	☐ Abandoned water well	Direction from well? at well site	☐ Cess pool	☐ Livestock pens	☐ Oil well/Gas well	How many feet? 0
☐ Septic tank	☐ Seepage pit	☐ Fuel storage	☒ Other (specify below)																	
☐ Sewer lines	☐ Pit privy	☐ Fertilizer storage	Carbon-Tetrachloride Remediation Site																	
☐ Watertight sewer lines	☐ Sewage lagoon	☐ Insecticide storage																		
☐ Lateral lines	☐ Feedyard	☐ Abandoned water well	Direction from well? at well site																	
☐ Cess pool	☐ Livestock pens	☐ Oil well/Gas well	How many feet? 0																	

FROM	TO	PLUGGING MATERIALS	FROM	TO	PLUGGING MATERIALS
24.6	3	Bentonite Holeplug			
3	0	Topsoil			Former 4th & Carey Source Area
					Remediation Project Well.

7 CONTRACTOR'S OR LANDOWNER'S CERTIFICATION: This water well was plugged under my jurisdiction and was completed on (mo/day/year) 11/03/2015 and this record is true to the best of my knowledge and belief. Kansas Water Well Contractor's License No. n/a. This Water Well Record was completed on (mo/day/year) 11/17/2015 under the business name of City of Hutchinson, KS by (signature) Donald Koci P.G.
--

Send one white copy to Kansas Department of Health & Environment, Geology Section, 1000 SW Jackson Street, Ste. 420, Topeka, KS 66612-1367. Send one copy to WATER WELL OWNER and retain one for your records.
Visit us at <http://www.kdheks.gov/waterwell/index.html> Telephone 785-296-5524.

KSA82a-1212

Revised 1/20/2015