

WATER WELL PLUGGING RECORD Form WWC-5P

KSA 82a-1212

ID NO.

BG-VMP-2

1 LOCATION OF WATER WELL: County: Reno	Fraction ¼ NW ¼ NW ¼ NW ¼	Section Number 16	Township Number T 23 S	Range Number 5 ☐ E ☒ W
---	-------------------------------------	-----------------------------	----------------------------------	---

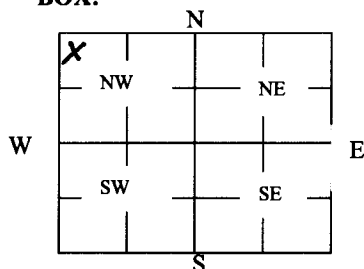
Street/Rural Address of Well Location; if unknown, distance & direction from nearest town or intersection: If at owner's address, check here ☐ **Cargill Grain Elevator**
309 N. Halstead St.
Hutchinson, KS 67501

Global Positioning Systems (GPS) information:

Latitude: **38.05555238** (in decimal degrees)
 Longitude: **-97.88431116** (in decimal degrees)
 Elevation: **1524**
 Horizontal Datum: ☐ WGS84, ☒ NAD83, ☐ NAD27
 Collection Method:

2 WATER WELL OWNER: City of Hutchinson
 RR#, St. Address, Box #: **PO Box 1567**
 City, State ZIP Code: **Hutchinson, KS 67504**

☒ GPS unit (Make/Model: **Topcon GRS-1**)
☐ Digital Map/Photo, ☐ Topographic Map, ☐ Land Survey
 Est. Accuracy: ☒ < 3 m, ☐ 3-5 m, ☐ 5-15 m, ☐ > 15 m

3 MARK WELL'S LOCATION WITH AN "X" IN SECTION BOX:**4 DEPTH OF WELL** 14 **ft.**WELL'S STATIC WATER LEVEL NONE ft

WELL WAS USED AS:

- | | | |
|-------------------------------------|---|--|
| ☐ Domestic | ☐ Public Water Supply | ☐ Dewatering |
| ☐ Irrigation | ☐ Oil Field Water Supply | ☐ Monitoring |
| ☐ Feedlot | ☐ Domestic (Lawn & Garden) | ☐ Injection Well |
| ☐ Industrial | ☐ Air Conditioning | ☒ Other <u>Vapor Monitor</u> |

Was a chemical/bacteriological sample submitted to Department? Yes ☐ No ☒**5 TYPE OF BLANK CASING USED:**

- ☐ Steel ☐ RMP (SR) ☐ Wrought ☐ Fiberglass ☐ Other (Specify below)
☒ PVC ☐ ABS ☐ Asbestos-Cement ☐ Concrete Tile

Blank casing diameter 1 in. Was casing pulled? Yes ☒ No ☐ If yes, how much ALL
 Casing height above or below land surface NA in.

6 GROUT PLUG MATERIAL: ☐ Neat cement ☐ Cement grout ☒ Bentonite ☐ Other _____Grout Plug Intervals: From 14 ft. to 3 ft., From _____ ft. to _____ ft., From _____ ft. to _____ ft.

What is the nearest source of possible contamination:

- | | | | |
|---|---|---|---|
| ☐ Septic tank | ☐ Seepage pit | ☐ Fuel storage | ☒ Other (specify below) |
| ☐ Sewer lines | ☐ Pit privy | ☐ Fertilizer storage | <u>Carbontetrachloride Remediation</u> |
| ☐ Watertight sewer lines | ☐ Sewage lagoon | ☐ Insecticide storage | |
| ☐ Lateral lines | ☐ Feedyard | ☐ Abandoned water well | Direction from well? <u>On site</u> |
| ☐ Cess pool | ☐ Livestock pens | ☐ Oil well/Gas well | How many feet? <u>On site</u> |

FROM	TO	PLUGGING MATERIALS	FROM	TO	PLUGGING MATERIALS
14	3	Bentonite Holeplug			
3	0	Topsoil			

7 CONTRACTOR'S OR LANDOWNER'S CERTIFICATION: This water well was plugged under my jurisdiction and was completed on (mo/day/year) April 27, 2016 and this record is true to the best of my knowledge and belief. Kansas Water Well Contractor's License No. N/A. This Water Well Record was completed on (mo/day/year) May 5, 2016 under the business name of City of Hutchinson by (signature) [Signature]

Send one white copy to Kansas Department of Health & Environment, Geology Section, 1000 SW Jackson Street, Ste. 420, Topeka, KS 66612-1367. Send one copy to WATER WELL OWNER and retain one for your records.

Visit us at <http://www.kdheks.gov/waterwell/index.html> Telephone 785-296-5524.

KSA82a-1212

Revised 1/20/2015