

WATER WELL PLUGGING RECORD Form WWC-5P
KSA 82a-1212
ID NO.
CMW-7D

1 LOCATION OF WATER WELL: County: Reno	Fraction ¼ NW¼ NW ¼ NW ¼	Section Number 16	Township Number T 23 S	Range Number 5 ☐ E ☒ W
---	------------------------------------	-----------------------------	----------------------------------	---

Street/Rural Address of Well Location; if unknown, distance & direction from nearest town or intersection: If at owner's address, check here ☐ **Cargill Grain Elevator**
309 N. Halstead St.
Hutchinson, KS 67501

Global Positioning Systems (GPS) information:

Latitude: **38.05574474** (in decimal degrees)

Longitude: **-97.88467846** (in decimal degrees)

Elevation: **1524**

Horizontal Datum: ☐ WGS84, ☒ NAD83, ☐ NAD27

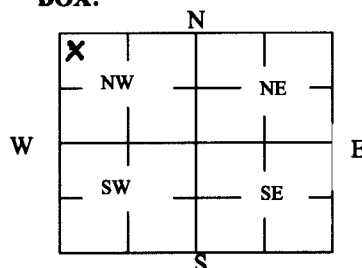
Collection Method:

☒ GPS unit (Make/Model: **Topcon GRS-1**)

☐ Digital Map/Photo, ☐ Topographic Map, ☐ Land Survey

Est. Accuracy: ☒ < 3 m, ☐ 3-5 m, ☐ 5-15 m, ☐ > 15 m

2 WATER WELL OWNER: **City of Hutchinson**
RR#, St. Address, Box #: **PO Box 1567**
City, State ZIP Code: **Hutchinson, KS 67504**

3 MARK WELL'S LOCATION WITH AN "X" IN SECTION BOX:


4 DEPTH OF WELL **66** ft.

WELL'S STATIC WATER LEVEL **15.62** ft

WELL WAS USED AS:

☐ Domestic
☐ Irrigation
☐ Feedlot
☐ Industrial

☐ Public Water Supply
☐ Oil Field Water Supply
☐ Domestic (Lawn & Garden)
☐ Air Conditioning

☐ Dewatering
☒ Monitoring
☐ Injection Well
☐ Other

Was a chemical/bacteriological sample submitted to Department? Yes ☐ No ☒

5 TYPE OF BLANK CASING USED:

☐ Steel ☐ RMP (SR) ☐ Wrought ☐ Fiberglass ☐ Other (Specify below)
☒ PVC ☐ ABS ☐ Asbestos-Cement ☐ Concrete Tile

Blank casing diameter **1.5** in. Was casing pulled? Yes ☐ No ☒ If yes, how much _____
Casing height above or below land surface **36** in.

6 GROUT PLUG MATERIAL: ☐ Neat cement ☐ Cement grout ☒ Bentonite ☐ Other _____

Grout Plug Intervals: From **66** ft. to **3** ft., From _____ ft. to _____ ft., From _____ ft. to _____ ft.

What is the nearest source of possible contamination:

☐ Septic tank ☐ Seepage pit ☐ Fuel storage
☐ Sewer lines ☐ Pit privy ☐ Fertilizer storage
☐ Watertight sewer lines ☐ Sewage lagoon ☐ Insecticide storage
☐ Lateral lines ☐ Feedyard ☐ Abandoned water well
☐ Cess pool ☐ Livestock pens ☐ Oil well/Gas well

☒ Other (specify below)
Carbontetrachloride Remediation

Direction from well? **On site**
How many feet? **On site**

FROM	TO	PLUGGING MATERIALS	FROM	TO	PLUGGING MATERIALS
66	3	Bentonite Holeplug			
3	0	Topsoil			

7 CONTRACTOR'S OR LANDOWNER'S CERTIFICATION: This water well was plugged under my jurisdiction and was completed on (mo/day/year) **April 27, 2016** and this record is true to the best of my knowledge and belief. Kansas Water Well Contractor's License No. **N/A**. This Water Well Record was completed on (mo/day/year) **May 5, 2016** under the business name of **City of Hutchinson** by (signature) **[Signature]**

Send one white copy to Kansas Department of Health & Environment, Geology Section, 1000 SW Jackson Street, Ste. 420, Topeka, KS 66612-1367. Send one copy to WATER WELL OWNER and retain one for your records.

Visit us at <http://www.kdheks.gov/waterwell/index.html> Telephone 785-296-5524.

KSA82a-1212
Revised 1/20/2015