
	WA	TER WELL PLUGGING F	RECORD Form WW	C-5P	KSA 82a	-1212 ID	NQ.				
		LOCATION OF WATER WELL: County: Reno	Fraction 1/4 NE 1/4 NW 1/4 NW 1/2		Number	Township Nu T 23		Range Number 5 E N W			
Γ		Street/Rural Address of Well Location;		Global Po	sitioning S	vstems (GPS	inforn	nation:			
		direction from nearest town or intersect		Latitude:	28,	050511	-	(in decimal degrees)			
l		check here 🔲 BNSF Railroad Ya	Latitude: 38.050511 (in decimal degrees) Longitude: -97.873018 (in decimal degrees) Elevation:								
		Street and Avenue	B; Hutchinson, KS	Horizontal Collection	Datum:	☐ WGS84,		NAD83, NAD27			
T	2	WATER WELL OWNER: BNS	GPS unit (Make/Model: Garmin etrek								
		RR#, St. Address, Box #: 4515 Ka		_	-		_	flap,			
L		City, State ZIP Code: Kansas Ci	1	Est. Accuracy: □ < 3 m, 3-5 m, □ 5-15 m, □ > 15 m							
	3	MARK WELL'S LOCATION WITH AN "X" IN SECTION	4 DEPTH OF WELL _	15.2	ft.						
		BOX:	WELL'S STATIC WA	TER LEVE	L	ft					
		WELL WAS USED AS:									
		NW NE	Domestic	Dublic W	ater Supply	, n	Dewat	tering			
			Irrigation		Water Sup	ply	Monit				
	W	E	Feedlot _		c (Lawn &		Inject	ion Well			
		sw se	Industrial L	Air Cone	ditioning	Ц	Other				
			Was a chemical/bacteri	ological sam	ple submitt	ed to Departn	nent? Y	es 🗌 No 🔭			
ľ	5	TYPE OF BLANK CASING USE	ED:		, , , ,						
		Steel RMP (SR)	Wrought TF	iberglass	По	ther (Specify	below)				
		PVC ABS	Wrought F Asbestos-Cement C	oncrete Tile							
		Blank casing diameter 2 in.	Was casing nulled? Yes	No \square	If yes how	w much all					
ŀ		Casing height above or below land	surface 30 in.		11) 40, 110			*			
-						 					
	6		Neat cement Ceme				,	V .			
		Grout Plug Intervals: From 0	ft. to 3 ft., From	n <u>3</u> f	t. to 15,2	tonite A Other 60 Soi					
		What is the nearest source of possible contamination:									
Ì			Geepage pit Fuel s it privy Fertili			Other (specify	below)				
		Sewer lines Pit privy Fertilizer storage Watertight sewer lines Sewage lagoon Insecticide storage									
١		Lateral lines F	eedyard Aband	oned water	well Dire	ection from w	ell?				
		Cess pool Livestock pens Oil well/Gas well How many feet?									
		FROM TO PLUG	GGING MATERIALS	FROM	TO	PLU(GGING	MATERIALS			
		0 3 Top Soil									
		3 15,2 Bentonite									
Ì											
1					l	<u> </u>					
	7	CONTRACTOR'S OR LANDON	VNER'S CERTIFICATION								
		completed on (mo/day/year) 8-31-2016 and this record is true to the best of my knowledge and belief. Kansas Water Well Contractor's License No. 710 . This Water Well Record was completed on (mo/day/year) 9-01-16 under the									
	business name of Below Ground Surface, Inc. by (signature)										
1	Send one white copy to Kansas Department of Health & Environment, Geology Section, 1000 SW Jackson Street, Ste. 420, Topeka, KS										
	Se		tment of Health & Environme end one copy to WATER WI								
			tp://www.kdheks.gov/waterw					••			
				.82a-1212				Revised 1/20/2015			
-1			N.S.P.	102a-1212				1/40/4013 Text 1/40/4013			



SAN	MPLES Recovery (Feet)					Project NameBNSF Hutchinson FFF Project Number						
Type F	Recovery (Feet)	-	Orill	WELL CONSTRUCTION			1149052.00	Well Name	MW-6			
		Penetr. Resist. Blows/2'	Depth (Feet)		USCS Lithology	Color	SAMPLE D	ESCRIPTION and DRILLING	REMARKS			
							7. SOIL SAMPLES	COORDINATES. WERE COLLECTED THE MONITORING VITEM AUGER.	VIA DIRECT PUSH VELL INSTALLED			
							*.					
									·			

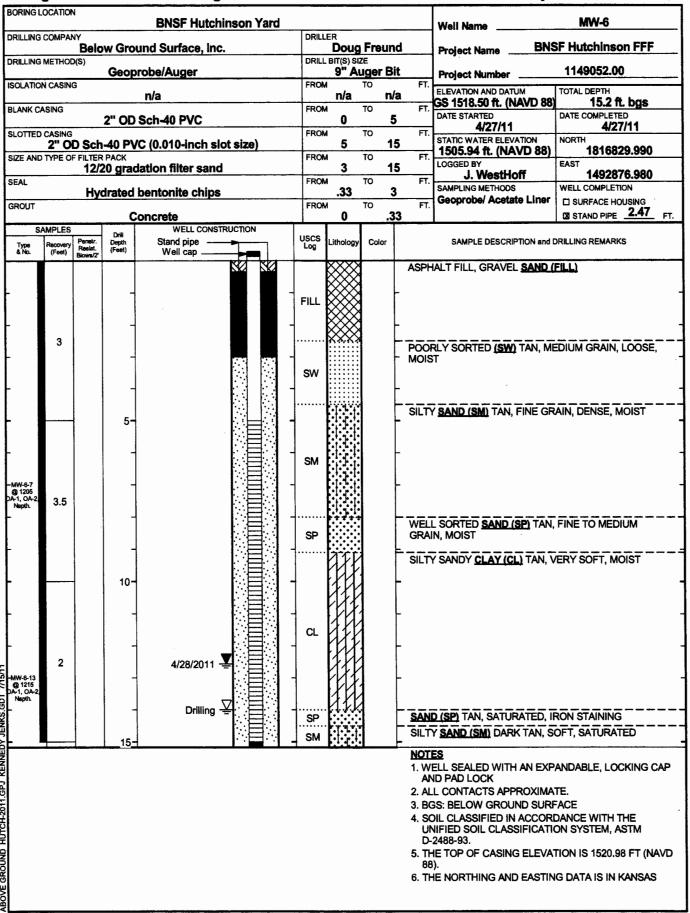