

# WATER WELL PLUGGING RECORD Form WWC-5P

KSA 82a-1212

ID NO.

40051 (dismissed)

<b>1 LOCATION OF WATER WELL:</b> County: <u>Reno</u>	Fraction <u>¼ NE ¼ NE ¼ SW ¼</u>	Section Number <u>12</u>	Township Number <u>T 23 S</u>	Range Number <u>5</u> <input type="checkbox"/> E <input checked="" type="checkbox"/> W
---	-------------------------------------	-----------------------------	----------------------------------	---

Street/Rural Address of Well Location; if unknown, distance & direction from nearest town or intersection: If at owner's address, check here ☒ 8 Lake Drive, Hutchinson, KS 67502

## Global Positioning Systems (GPS) information:

Latitude: 38.06441 (in decimal degrees)

Longitude: -97.82162 (in decimal degrees)

Elevation:

Horizontal Datum: ☐ WGS84, ☐ NAD83, ☒ NAD27

Collection Method:


☒ GPS unit (Make/Model: Garmin GPSmap 60CSx)

☐ Digital Map/Photo, ☐ Topographic Map, ☐ Land Survey

Est. Accuracy: ☐ < 3 m, ☒ 3-5 m, ☐ 5-15 m, ☐ > 15 m

**2 WATER WELL OWNER:** Richard D. Mayfield  
RR#, St. Address, Box #: 8 Lake Drive  
City, State ZIP Code: Hutchinson, KS 67501

## 3 MARK WELL'S LOCATION WITH AN "X" IN SECTION BOX:

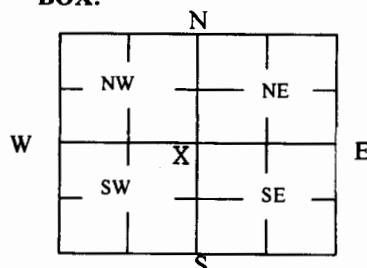

**4 DEPTH OF WELL** 93.5 ft.

WELL'S STATIC WATER LEVEL 12 ft

WELL WAS USED AS:

☐ Domestic  
☐ Irrigation  
☐ Feedlot  
☒ Industrial

☐ Public Water Supply  
☐ Oil Field Water Supply  
☐ Domestic (Lawn & Garden)  
☐ Air Conditioning

☐ Dewatering  
☐ Monitoring  
☐ Injection Well  
☐ Other

Was a chemical/bacteriological sample submitted to Department? Yes ☐ No ☒

## 5 TYPE OF BLANK CASING USED:

☐ Steel  
☒ PVC

☐ RMP (SR)  
☐ ABS

☐ Wrought  
☐ Asbestos-Cement

☐ Fiberglass  
☐ Concrete Tile

☐ Other (Specify below)

Blank casing diameter 6 in. Was casing pulled? Yes ☐ No ☒ If yes, how much

Casing height above or below land surface below 36 in.

**6 GROUT PLUG MATERIAL:** ☐ Neat cement ☐ Cement grout ☒ Bentonite ☐ Other

Grout Plug Intervals: From 13 ft. to 3 ft., From \_\_\_\_\_ ft. to \_\_\_\_\_ ft., From \_\_\_\_\_ ft. to \_\_\_\_\_ ft.

What is the nearest source of possible contamination:

☐ Septic tank  
☐ Sewer lines  
☐ Watertight sewer lines  
☐ Lateral lines  
☐ Cess pool

☐ Seepage pit  
☐ Pit privy  
☐ Sewage lagoon  
☐ Feedyard  
☐ Livestock pens

☒ Fuel storage  
☐ Fertilizer storage  
☐ Insecticide storage  
☐ Abandoned water well  
☐ Oil well/Gas well

☐ Other (specify below)

Direction from well? southwest

How many feet? approximately 460 ft

FROM	TO	PLUGGING MATERIALS	FROM	TO	PLUGGING MATERIALS
93.5	13	Clean, coarse sand			Well plugging witnessed by
13	3	Bentonite Holeplug Chips			D. Randolph, GMD2 staff on
3	0	Topsoil			5/17/17 and 5/18/17.

**7 CONTRACTOR'S OR LANDOWNER'S CERTIFICATION:** This water well was plugged under my jurisdiction and was completed on (mo/day/year) 5/18/2017 and this record is true to the best of my knowledge and belief. Kansas Water Well Contractor's License No. 855. This Water Well Record was completed on (mo/day/year) 5/19/2017 under the business name of MAKELA FISH by (signature) [Signature]

Send one whole copy to Kansas Department of Health & Environment, Geology Section, 1000 SW Jackson Street, Ste. 420, Topeka, KS 66612-1367. Send one copy to WATER WELL OWNER and retain one for your records.

JUN 02 2017

Visit us at <http://www.kdheks.gov/waterwell/index.html> Telephone 785-296-5524.

KSA82a-1212

Revised 1/20/2015