


**WATER WELL RECORD Form WWC-5**

Division of Water Resources App. No.   Well ID  

Original Record  Correction  Change in Well Use

**1 LOCATION OF WATER WELL:** County: Reno Fraction: NE 1/4 NW 1/4 SW 1/4 Section Number: 18 Township Number: T 23 S Range Number: R 5 E W

**2 WELL OWNER:** Last Name: Maquna First: Alberto Street or Rural Address where well is located (if unknown, distance and direction from nearest town or intersection): If at owner's address, check here:   
 Business Address: 540 East Avenue B  
 City: Hutchinson State: Ks. ZIP: 67501

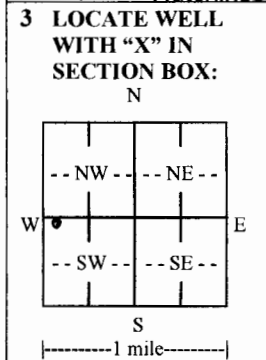

**4 DEPTH OF COMPLETED WELL:** 41 ft.  
 Depth(s) Groundwater Encountered: 1)            ft.  
 2)            ft. 3)            ft., or 4)  Dry Well  
 WELL'S STATIC WATER LEVEL: 16 ft.  
 below land surface, measured on (mo-day-yr) 7/6/2018.  
 above land surface, measured on (mo-day-yr)           .  
 Pump test data: Well water was            ft.  
 after            hours pumping            gpm  
 Well water was            ft.  
 after            hours pumping            gpm  
 Estimated Yield:            gpm  
 Bore Hole Diameter: 9 in. to 41 ft. and  
           in. to            ft.

**5 Latitude:** 38.04997 (decimal degrees)  
**Longitude:** 097.91956 (decimal degrees)  
 Horizontal Datum:  WGS 84  NAD 83  NAD 27  
 Source for Latitude/Longitude:  
 GPS (unit make/model: Garmin 62S)  
 (WAAS enabled?  Yes  No)  
 Land Survey  Topographic Map  
 Online Mapper:           

**6 Elevation:** 1522 ft.  Ground Level  TOC  
 Source:  Land Survey  GPS  Topographic Map  
 Other           

**7 WELL WATER TO BE USED AS:**

|  |   |   |
|--|---|---|
| 1. Domestic: <input type="checkbox"/> Household <input checked="" type="checkbox"/> Lawn & Garden <input type="checkbox"/> Livestock | 5. <input type="checkbox"/> Public Water Supply: well ID <u>          </u>  | 10. <input type="checkbox"/> Oil Field Water Supply: lease <u>          </u>  |
| 2. <input type="checkbox"/> Irrigation   | 6. <input type="checkbox"/> Dewatering: how many wells? <u>          </u>   | 11. Test Hole: well ID <u>          </u><br><input type="checkbox"/> Cased <input type="checkbox"/> Uncased <input type="checkbox"/> Geotechnical |
| 3. <input type="checkbox"/> Feedlot  | 7. <input type="checkbox"/> Aquifer Recharge: well ID <u>          </u>   | 12. Geothermal: how many bores? <u>          </u><br>a) Closed Loop <input type="checkbox"/> Horizontal <input type="checkbox"/> Vertical         |
| 4. <input type="checkbox"/> Industrial   | 8. <input type="checkbox"/> Monitoring: well ID <u>          </u>   | b) Open Loop <input type="checkbox"/> Surface Discharge <input type="checkbox"/> Inj. of Water  |
|  | 9. Environmental Remediation: well ID <u>          </u><br><input type="checkbox"/> Air Sparge <input type="checkbox"/> Soil Vapor Extraction<br><input type="checkbox"/> Recovery <input type="checkbox"/> Injection | 13. <input type="checkbox"/> Other (specify): <u>          </u>   |

**Was a chemical/bacteriological sample submitted to KDHE?**  Yes  No If yes, date sample was submitted:             
 Water well disinfected?  Yes  No

**8 TYPE OF CASING USED:**  Steel  PVC  Other            CASING JOINTS:  Glued  Clamped  Welded  Threaded  
 Casing diameter 5 in. to 31 ft., Diameter            in. to            ft., Diameter            in. to            ft.  
 Casing height above land surface 18 in. Weight 160 lbs./ft. Wall thickness or gauge No. 214

**TYPE OF SCREEN OR PERFORATION MATERIAL:**  
 Steel  Stainless Steel  Fiberglass  PVC  Other (Specify)             
 Brass  Galvanized Steel  Concrete tile  None used (open hole)

**SCREEN OR PERFORATION OPENINGS ARE:**  
 Continuous Slot  Mill Slot  Gauze Wrapped  Torch Cut  Drilled Holes  Other (Specify)             
 Louvered Shutter  Key Punched  Wire Wrapped  Saw Cut  None (Open Hole)

**SCREEN-PERFORATED INTERVALS:** From 31 ft. to 41 ft., From            ft. to            ft., From            ft. to            ft.  
**GRAVEL PACK INTERVALS:** From 41 ft. to 15 ft., From            ft. to            ft., From            ft. to            ft.

**9 GROUT MATERIAL:**  Neat cement  Cement grout  Bentonite  Other             
 Grout Intervals: From 15 ft. to 0 ft., From            ft. to            ft., From            ft. to            ft.

**Nearest source of possible contamination:**  
 Septic Tank  Lateral Lines  Pit Privy  Livestock Pens  Insecticide Storage  
 Sewer Lines  Cess Pool  Sewage Lagoon  Fuel Storage  Abandoned Water Well  
 Watertight Sewer Lines  Seepage Pit  Feedyard  Fertilizer Storage  Oil Well/Gas Well  
 Other (Specify)           

Direction from well? West Distance from well? 28' ft.

| 10 FROM | TO | LITHOLOGIC LOG     | FROM | TO | LITHO. LOG (cont.) or PLUGGING INTERVALS |
|---------|----|--------------------|------|----|--|
| 0       | 3  | Top soil           |      |    |  |
| 3       | 10 | Brown clay         |      |    |  |
| 10      | 41 | Med. sand & gravel |      |    |  |
|         |    |                    |      |    |  |
|         |    |                    |      |    |  |
|         |    |                    |      |    |  |
| Notes:  |    |                    |      |    |  |

**11 CONTRACTOR'S OR LANDOWNER'S CERTIFICATION:** This water well was  constructed,  reconstructed, or  plugged under my jurisdiction and was completed on (mo-day-year) 7/6/2018 and this record is true to the best of my knowledge and belief. Kansas Water Well Contractor's License No. 134 This Water Well Record was completed on (mo-day-year) 7/16/2018 under the business name of Rosencrantz-Bemis Ent. Signature C. J. Bunnell