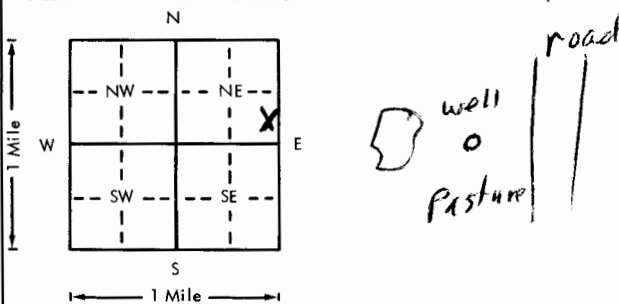


USE TYPEWRITER OR BALL
POINT PEN-PRESS FIRMLY,
PRINT CLEARLY.

WATER WELL RECORD
KSA 82a-1201-1215

Kansas Department of Health and
Environment-Division of Environment
(Water well Contractors)
Topeka, Kansas 66620

1. Location of well:		County <u>Reino</u>	Fraction <u>E 1/4 SE 1/4 NE 1/4</u>	Section number <u>1</u>	Township number <u>T 23 S</u>	Range number <u>R 5 E</u>
2. Distance and direction from nearest town or city: <u>1/2 mi. S. of 30th & Reno Rd</u> Street address of well location if in city: <u>E. of Hutchinson</u>		3. Owner of well: <u>Tom Beal</u> R.R. or street: <u>RR 4</u> City, state, zip code: <u>Hutchinson Kan 67501</u>				
4. Locate with "X" in section below: 		6. Bore hole dia. <u>12</u> in. Completion date <u>7-27-76</u> Well depth <u>40</u> ft.				
		7. <input checked="" type="checkbox"/> Cable tool <input checked="" type="checkbox"/> Rotary <input type="checkbox"/> Driven <input type="checkbox"/> Dug <input type="checkbox"/> Hollow rod <input type="checkbox"/> Jetted <input type="checkbox"/> Bored <input type="checkbox"/> Reverse rotary				
		8. Use: <input type="checkbox"/> Domestic <input type="checkbox"/> Public supply <input type="checkbox"/> Industry <input type="checkbox"/> Irrigation <input type="checkbox"/> Air conditioning <input checked="" type="checkbox"/> Stock <input type="checkbox"/> Lawn <input type="checkbox"/> Oil field water <input type="checkbox"/> Other				
		9. Casing: Material <u>Plastic</u> Height: <u>Above</u> or below Threading <u>Welded</u> Surface <u>12</u> in. RMP <input checked="" type="checkbox"/> PVC <input type="checkbox"/> Weight <u>12</u> lbs./ft. Dia. <u>6</u> in. to <u>40</u> ft. depth Wall Thickness: inches or Dia. <u>6</u> in. to <u>40</u> ft. depth gage No. <u>175</u>				
5. Type and color of material		From	To			
<u>Sandy soil</u>		<u>0</u>	<u>3</u>	10. Screen: Manufacturer's name <u>J&L</u>		
<u>brown sandy clay</u>		<u>3</u>	<u>6</u>	Type <u>RMP</u> Dia. <u>6"</u>		
<u>fine sand</u>		<u>6</u>	<u>11</u>	Slot/gauze <u>1/8 hole</u> Length <u>25</u>		
<u>brown sandy clay</u>		<u>11</u>	<u>14</u>	Set between <u>15</u> ft. and <u>40</u> ft.		
<u>brown & grey clay</u>		<u>14</u>	<u>25</u>	Gravel pack? <u>yes</u> Size range of material <u>1/8-1/4"</u>		
<u>fine sand</u>		<u>25</u>	<u>32</u>	11. Static water level: <u>7</u> ft. below land surface Date <u>7-27-76</u>		
<u>brown sandy clay</u>		<u>32</u>	<u>36</u>	12. Pumping level below land surfaces: <u>15</u> ft. after <u>1</u> hrs. pumping <u>15</u> g.p.m.		
<u>brown & grey clay</u>		<u>36</u>	<u>40</u>	<u>15</u> ft. after <u> </u> hrs. pumping <u> </u> g.p.m.		
				Estimated maximum yield <u>15</u> g.p.m.		
				13. Water sample submitted: <u> </u> mo./day/yr. <u> </u> Yes <input checked="" type="checkbox"/> No <u> </u> Date <u> </u>		
				14. Well head completion: <u>24</u> inches above grade <u> </u> Pitless adapter		
				15. Well grouted? <u>yes</u> With: <input checked="" type="checkbox"/> Neat cement <u> </u> Bentonite <u> </u> Concrete <u> </u> Depth: From <u>2</u> ft. to <u>10</u> ft.		
				16. Nearest source of possible contamination: <u>Pond</u> ft. <u>50</u> Direction <u>W</u> Type <u>Pond</u> Well disinfected upon completion? <u> </u> Yes <input checked="" type="checkbox"/> No <u> </u>		
				17. Pump: <u>Not installed</u> Manufacturer's name <u>Windmill</u> Model number <u> </u> HP <u> </u> Volts <u> </u> Length of drop pipe <u> </u> ft. capacity <u> </u> g.p.m. Type: <u> </u> Submersible <u> </u> Turbine <u> </u> Jet <u> </u> Reciprocating <u> </u> Centrifugal <input checked="" type="checkbox"/> Other		
18. Elevation:		19. Remarks:		20. Water well contractor's certification: This well was drilled under my jurisdiction and this report is true to the best of my knowledge and belief. <u>Price Water Well 193</u> Business name <u>RR 3 Hutchinson</u> License No. <u> </u> Address <u> </u> Signed <u>John P. Parnell</u> Date <u>7-30-76</u> Authorized representative		