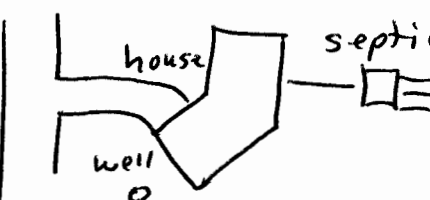


USE TYPEWRITER OR BALL  
POINT PEN-PRESS FIRMLY,  
PRINT CLEARLY.

WATER WELL RECORD  
KSA 82a-1201-1215

Kansas Department of Health and  
Environment-Division of Environment  
(Water well Contractors)  
Topeka, Kansas 66620

1. Location of well:		County <b>Reno</b>	Fraction <b>NW 1/4 NW 1/4 NW 1/4</b>	Section number <b>2</b>	Township number <b>T 23 S</b>	Range number <b>R 5 E</b>						
2. Distance and direction from nearest town or city: <b>2930 N. Obee Rd</b> Street address of well location if in city: <b>Hutchinson</b>				3. Owner of well: <b>L.L. McCormick</b> R.R. or street: <b>2930 N. Obee Rd</b> City, state, zip code: <b>Hutchinson Kan. 67501</b>								
4. Locate with "X" in section below:		Sketch map:		6. Bore hole dia. <b>12</b> in. Completion date Well depth <b>108</b> ft. <b>8-5-76</b>								
<div style="text-align: center;">N 1 Mile W E S 1 Mile</div> <div style="text-align: center;"><table border="1" style="margin: auto;"><tr><td style="text-align: center;">X</td><td style="text-align: center;"> </td></tr><tr><td style="text-align: center;">NW</td><td style="text-align: center;">NE</td></tr><tr><td style="text-align: center;">SW</td><td style="text-align: center;">SE</td></tr></table></div>		X		NW	NE	SW	SE			7. <input checked="" type="checkbox"/> Cable tool <input checked="" type="checkbox"/> Rotary <input type="checkbox"/> Driven <input type="checkbox"/> Dug <input type="checkbox"/> Hollow rod <input type="checkbox"/> Jetted <input type="checkbox"/> Bored <input type="checkbox"/> Reverse rotary		
X												
NW	NE											
SW	SE											
5. Type and color of material				8. Use: <input type="checkbox"/> Domestic <input type="checkbox"/> Public supply <input type="checkbox"/> Industry <input type="checkbox"/> Irrigation <input type="checkbox"/> Air conditioning <input type="checkbox"/> Stock <input checked="" type="checkbox"/> Lawn <input type="checkbox"/> Oil field water <input type="checkbox"/> Other								
				9. Casing: Material <b>Plas</b> Height: <input checked="" type="checkbox"/> Above or below Threaded <input type="checkbox"/> Welded <b>6</b> Surface <b>12</b> in. RMP <input checked="" type="checkbox"/> PVC <input type="checkbox"/> Weight <input type="checkbox"/> lbs./ft. Dia. <b>6</b> in. to <b>108</b> ft. depth Wall Thickness: inches or Dia. <input type="checkbox"/> in. to <input type="checkbox"/> ft. depth Gauge No. <b>175</b>								
				10. Screen: Manufacturer's name <b>J&amp;L</b> Type <b>RMP</b> Dia. <b>6"</b> Slot/gauze <b>1/8 hole</b> Length <b>30</b> Set between <b>78</b> ft. and <b>108</b> ft. <input type="checkbox"/> ft. and <input type="checkbox"/> ft. Gravel pack? <input checked="" type="checkbox"/> Size range of material <b>1/8-1/2</b>								
				11. Static water level: <input type="checkbox"/> mo./day/yr. <b>35</b> ft. below land surface Date <b>8-5-76</b>								
				12. Pumping level below land surfaces: <b>52</b> ft. after <b>2</b> hrs. pumping <b>20</b> g.p.m. <input type="checkbox"/> ft. after <input type="checkbox"/> hrs. pumping <input type="checkbox"/> g.p.m. Estimated maximum yield <b>30</b> g.p.m.								
				13. Water sample submitted: <input type="checkbox"/> mo./day/yr. <input type="checkbox"/> Yes <input checked="" type="checkbox"/> No Date <input type="checkbox"/>								
				14. Well head completion: <input type="checkbox"/> Pitless adapter <b>12</b> Inches above grade								
				15. Well grouted? <b>yes</b> With: <input type="checkbox"/> Neat cement <input type="checkbox"/> Bentonite <input checked="" type="checkbox"/> Concrete Depth: From <b>3</b> ft. to <b>13</b> ft.								
(Use a second sheet if needed)				16. Nearest source of possible contamination: ft. <b>70</b> Direction <b>NE</b> Type <b>Septic</b> Well disinfected upon completion? <input checked="" type="checkbox"/> Yes <input type="checkbox"/> No								
				17. Pump: <input checked="" type="checkbox"/> Not installed Manufacturer's name <input type="checkbox"/> Model number <input type="checkbox"/> HP <input type="checkbox"/> Volts <input type="checkbox"/> Length of drop pipe <input type="checkbox"/> ft. capacity <input type="checkbox"/> g.p.m. Type: <input type="checkbox"/> Submersible <input type="checkbox"/> Turbine <input type="checkbox"/> Jet <input type="checkbox"/> Reciprocating <input type="checkbox"/> Centrifugal <input type="checkbox"/> Other								
				18. Elevation:								
				19. Remarks:								
20. Water well contractor's certification: This well was drilled under my jurisdiction and this report is true to the best of my knowledge and belief. <b>Price Water Well 193</b> Business name <b>RR3 Hutchinson</b> License No. <b>2-217</b> Address <b>John Davenport</b> Date <b>7-21-76</b> Signed <input type="checkbox"/> Authorized representative												

Forward the white, blue and pink copies to the Department of Health and Environment

Form WWC-5