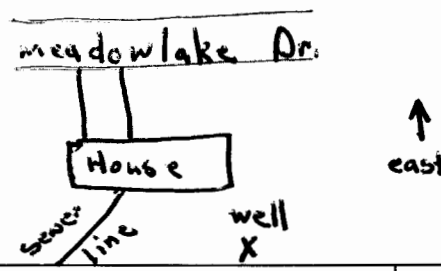


USE TYPEWRITER OR BALL POINT PEN—PRESS FIRMLY, PRINT CLEARLY.

WATER WELL RECORD
KSA 82a-1201-1215

Kansas Department of Health and Environment—Division of Environment
(Water well Contractors)
Topeka, Kansas 66620

1. Location of well:	County Reno	X Fraction NW 1/4 NE 1/4	Section number 4	Township number T 23 S	Range number R 5 E/W		
2. Distance and direction from nearest town or city: 1/2 mi. east of Hutchinson on 30th St. Street address of well location if in city:			3. Owner of well: John S. Stephens R.R. or street: 2905 N. Meadowlake Dr. City, state, zip code: Hutchinson, Ks. 67501				
X Locate with "X" in section below: N W E S 1 Mile		Sketch map: 		6. Bore hole dia. 12 3/4 in. Completion date 10/15/78 Well depth 90 ft.			
5. Type and color of material		From		To			
		Top soil		1	3	7. Cable tool <input checked="" type="checkbox"/> Rotary <input type="checkbox"/> Driven <input type="checkbox"/> Dug <input type="checkbox"/> Hollow rod <input type="checkbox"/> Jetted <input type="checkbox"/> Bored <input type="checkbox"/> Reverse rotary	
		gray clay		3	7	8. Use: <input checked="" type="checkbox"/> Domestic <input type="checkbox"/> Public supply <input type="checkbox"/> Industry <input type="checkbox"/> Irrigation <input type="checkbox"/> Air conditioning <input type="checkbox"/> Stock <input type="checkbox"/> Lawn <input type="checkbox"/> Oil field water <input type="checkbox"/> Other	
		very fine sand + grey clay		7	17	9. Casing: Material plis Height: Above or below Threaded <input type="checkbox"/> Welded <input checked="" type="checkbox"/> Surface 12 in. RMP <input type="checkbox"/> PVC <input checked="" type="checkbox"/> Weight <input type="checkbox"/> lbs./ft. Dia. 6 in. to 49 ft. depth Wall Thickness: inches or Dia. <input type="checkbox"/> in. to <input type="checkbox"/> ft. depth gage No. 349	
		fine sand		17	28	10. Screen: Manufacturer's name none Type <input type="checkbox"/> Dia. <input type="checkbox"/> Slot/gauze <input type="checkbox"/> Length <input type="checkbox"/> Set between <input type="checkbox"/> ft. and <input type="checkbox"/> ft. <input type="checkbox"/> ft. and <input type="checkbox"/> ft. Gravel pack? <input checked="" type="checkbox"/> Size range of material <input type="checkbox"/>	
		gray clay		28	30	11. Static water level: <input type="checkbox"/> mo./day/yr. 75 ft. below land surface Date 10/15/78	
		fine sand + gray clay		30	35	12. Pumping level below land surfaces: 80 ft. after 1 hrs. pumping 9 g.p.m. <input type="checkbox"/> ft. after <input type="checkbox"/> hrs. pumping <input type="checkbox"/> g.p.m. Estimated maximum yield 15 g.p.m.	
		med. fine sand + gray clay		35	40	13. Water sample submitted: <input type="checkbox"/> mo./day/yr. <input type="checkbox"/> Yes <input checked="" type="checkbox"/> No Date <input type="checkbox"/>	
		fine sand + gray clay		40	47	14. Well head completion: <input type="checkbox"/> Pitless adapter 12 Inches above grade	
		red clay		47	49	15. Well grouted? yes With: <input checked="" type="checkbox"/> Neat cement <input type="checkbox"/> Bentonite <input type="checkbox"/> Concrete Depth: From 4 ft. to 14 ft.	
reduced hole size to 5"				16. Nearest source of possible contamination: sewer line ft. 75 Direction north Type <input type="checkbox"/> Well disinfected upon completion? <input checked="" type="checkbox"/> Yes <input type="checkbox"/> No			
permable red rock		49	90	17. Pump: <input checked="" type="checkbox"/> Not installed Manufacturer's name <input type="checkbox"/> Model number <input type="checkbox"/> HP <input type="checkbox"/> Volts <input type="checkbox"/> Length of drop pipe <input type="checkbox"/> ft. capacity <input type="checkbox"/> g.p.m. Type: <input type="checkbox"/> Submersible <input type="checkbox"/> Turbine <input type="checkbox"/> Jet <input type="checkbox"/> Reciprocating <input type="checkbox"/> Centrifugal <input type="checkbox"/> Other			
(Use a second sheet if needed)							
18. Elevation: Topography: <input type="checkbox"/> Hill <input type="checkbox"/> Slope <input checked="" type="checkbox"/> Upland <input type="checkbox"/> Valley		19. Remarks: Customer knows that installation of concrete slab is regulation		20. Water well contractor's certification: This well was drilled under my jurisdiction and this report is true to the best of my knowledge and belief. Inc Hydra Well Contractors Business name License No. 381 Address RR5 Hutchinson, Ks Signed Ray Campbell Date 11/6/78 Authorized Representative			

23-50-4 NW NW NE
 T 23 S R 5 E/W
 Sec 4