

WATER WELL PLUGGING RECORD Form WWC-5P

KSA 82a-1212

ID NO.

LFMW-4D

1 LOCATION OF WATER WELL: County: RENO Fraction $\frac{1}{4}$ NE $\frac{1}{4}$ SW $\frac{1}{4}$ NW $\frac{1}{4}$ Section Number 17 Township Number 23 T S Range Number 5 ☐ E ☒ W

Street/Rural Address of Well Location; if unknown, distance & direction from nearest town or intersection: If at owner's address, check here ☐ SOUTH OF 1ST AND LORRAINE


Global Positioning Systems (GPS) information:

Latitude: UNKNOWN (in decimal degrees)
Longitude: (in decimal degrees)
Elevation:
Horizontal Datum: ☐ WGS84, ☐ NAD83, ☐ NAD27
Collection Method:

2 WATER WELL OWNER: LOWEN CORPORATION
RR#, St. Address, Box #: 1501 N HALSTEAD
City, State ZIP Code: HUTCHINSON KS 67502

☐ GPS unit (Make/Model: _____)
☐ Digital Map/Photo, ☐ Topographic Map, ☐ Land Survey
Est. Accuracy: ☐ < 3 m, ☐ 3-5 m, ☐ 5-15 m, ☐ > 15 m

3 MARK WELL'S LOCATION WITH AN "X" IN SECTION BOX:

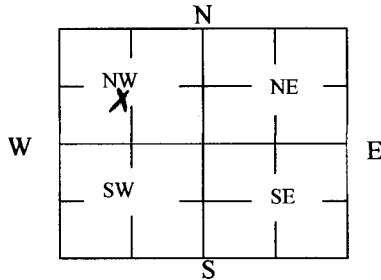

4 DEPTH OF WELL 55 ft.

WELL'S STATIC WATER LEVEL _____ ft

WELL WAS USED AS:

☐ Domestic
☐ Irrigation
☐ Feedlot
☐ Industrial

☐ Public Water Supply
☐ Oil Field Water Supply
☐ Domestic (Lawn & Garden)
☐ Air Conditioning

☒ Dewatering
☐ Monitoring
☐ Injection Well
☐ Other _____

Was a chemical/bacteriological sample submitted to Department? Yes ☐ No ☐

5 TYPE OF BLANK CASING USED:

☐ Steel ☐ RMP (SR) ☐ Wrought ☐ Fiberglass ☐ Other (Specify below)
☒ PVC ☐ ABS ☐ Asbestos-Cement ☐ Concrete Tile

Blank casing diameter .5 in. Was casing pulled? Yes ☒ No ☐ If yes, how much TOP 5FT
Casing height above or below land surface 0 in.

6 GROUT PLUG MATERIAL: ☐ Neat cement ☐ Cement grout ☒ Bentonite ☐ Other _____

Grout Plug Intervals: From 55 ft. to 1 ft., From _____ ft. to _____ ft., From _____ ft. to _____ ft.

What is the nearest source of possible contamination:

☐ Septic tank ☐ Seepage pit ☐ Fuel storage ☐ Other (specify below)
☐ Sewer lines ☐ Pit privy ☐ Fertilizer storage
☐ Watertight sewer lines ☐ Sewage lagoon ☐ Insecticide storage
☐ Lateral lines ☐ Feedyard ☐ Abandoned water well Direction from well? _____
☐ Cess pool ☐ Livestock pens ☐ Oil well/Gas well How many feet? _____

FROM	TO	PLUGGING MATERIALS	FROM	TO	PLUGGING MATERIALS
55	1	BENTONITE SLURRY			

7 CONTRACTOR'S OR LANDOWNER'S CERTIFICATION: This water well was plugged under my jurisdiction and was completed on (mo/day/year) 10/24/18 and this record is true to the best of my knowledge and belief. Kansas Water Well Contractor's License No. 709. This Water Well Record was completed on (mo/day/year) 11/2/18 under the business name of PLAINS ENVIRONMENTAL SERVICES, INC. by (signature) JESSE KALVIG

Send one white copy to Kansas Department of Health & Environment, Geology Section, 1000 SW Jackson Street, Ste. 420, Topeka, KS 66612-1367. Send one copy to WATER WELL OWNER and retain one for your records.
Visit us at <http://www.kdheks.gov/waterwell/index.html> Telephone 785-296-5524.

KSA82a-1212

Revised 1/20/2015