


1 LOCATION OF WATER WELL:		Fraction	Section Number	Township Number	Range Number
County:	<i>Reno</i>	<i>NE 1/4 SW 1/4 NE 1/4</i>	<i>4</i>	T <i>23</i> S	R <i>5</i> <i>EW</i>

Distance and direction from nearest town or city street address of well if located within city?
2418 Howell St in Hutchinson

2	WATER WELL OWNER:	Dallas Schwartz	
	RR#, St. Address, Box # :	2418 Howell	Board of Agriculture, Division of Water Resources
	City, State, ZIP Code :	Hutch, KS 67502	Application Number:

3 LOCATE WELL'S LOCATION WITH AN "X" IN SECTION BOX: 4 DEPTH OF COMPLETED WELL... 106 ... ft. ELEVATION: ...
Depth(s) Groundwater Encountered 1. ... ft. 2. ... ft. 3. ... ft.

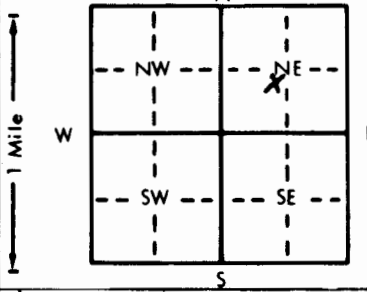

4) DEPTH OF COMPLETED WELL... 106 ft. ELEVATION: _____

Depth(s) Groundwater Encountered 1. _____ ft. 2. _____ ft. 3. _____ ft.

WELL'S STATIC WATER LEVEL... 26 ft. below land surface measured on mo/day/yr 4-13-92

Pump test data: Well water was 100 ft. after 2 hours pumping 20 gpm

Est. Yield _____ gpm: Well water was _____ ft. after _____ hours pumping _____ gpm

Bore Hole Diameter... 9 in. to 40 ft., and 5'2 in. to 106 ft.

WELL WATER TO BE USED AS:

5 Public water supply	8 Air conditioning	11 Injection well
1 Domestic	3 Feedlot	6 Oil field water supply
2 Irrigation	4 Industrial	9 Dewatering
	<u>7</u> Lawn and garden only	12 Other (Specify below)
	10 Monitoring well	

Was a chemical/bacteriological sample submitted to Department? Yes _____ No X; If yes, mo/day/yr sample was submitted _____

Water Well Disinfected? Yes X No _____

5 TYPE OF BLANK CASING USED:

1 Steel	3 RMP (SR)	5 Wrought iron	8 Concrete tile	CASING JOINTS: Glued ☒	Clamped
② PVC	4 ABS	6 Asbestos-Cement	9 Other (specify below)	Welded	
		7 Fiberglass		Threaded	

Blank casing diameter 6 in. to 70 ft., Dia in. to ft., Dia in. to ft.
Casing height above land surface 12 in., weight 3-37 lbs./ft. Wall thickness or gauge No. 160

TYPE OF SCREEN OR PERFORATION MATERIAL:

1 Steel	3 Stainless steel	5 Fiberglass	7 PVC	10 Asbestos-cement
2 Brass	4 Galvanized steel	6 Concrete tile	8 RMP (SR)	11 Other (specify)
			9 ABS	<u>12</u> None used (open hole)

SCREEN OR PERFORATION OPENINGS ARE:


1 Continuous slot	3 Mill slot	5 Gauzed wrapped	8 Saw cut	9 Drilled holes
2 Louvered shutter	4 Key punched	6 Wire wrapped	7 Torch cut	10 Other (specify)

SCREEN-PERFORATED INTERVALS:	From	ft. to	ft., From	ft. to	ft.
	From	ft. to	ft., From	ft. to	ft.
GRAVEL PACK INTERVALS:	From	ft. to	ft., From	ft. to	ft.
	From	ft. to	ft., From	ft. to	ft.

6 GROUT MATERIAL: 1 Neat cement 2 Cement grout 3 Bentonite 4 Other _____
Grout Intervals: From 2 ft. to 22 ft., From 7.5 ft. to 10 ft., From _____ ft. to _____ ft.

What is the nearest source of possible contamination:

1 Septic tank	4 Lateral lines	7 Pit privy	10 Livestock pens	14 Abandoned water well
2 Sewer lines	5 Cess pool	8 Sewage lagoon	11 Fuel storage	15 Oil well/Gas well
3 Watertight sewer lines	6 Seepage pit	9 Feedyard	12 Fertilizer storage	16 Other (specify below)
			13 Insecticide storage	

Direction from well? S How many feet? 27

[illegible]

7 CONTRACTOR'S OR LANDOWNER'S CERTIFICATION: This water well was ① constructed, (2) reconstructed, or (3) plugged under my jurisdiction and was completed on (mo/day/year) 4-13-92 and this record is true to the best of my knowledge and belief. Kansas Water Well Contractor's License No. 447 This Water Well Record was completed on (mo/day/yr) 6-1-92 under the business name of Miller Drilling by (signature) E. Miller