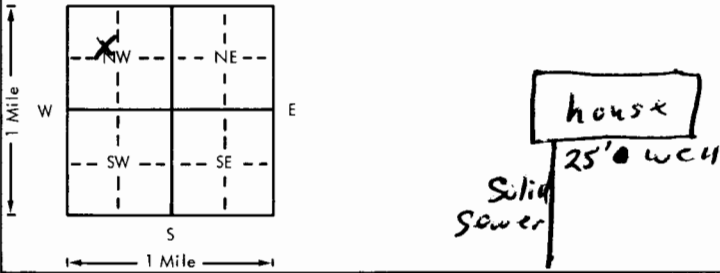


USE TYPEWRITER OR BALL
POINT PEN-PRESS FIRMLY,
PRINT CLEARLY.

WATER WELL RECORD
KSA 82a-1201-1215

Kansas Department of Health and
Environment-Division of Environment
(Water well Contractors)
Topeka, Kansas 66620

1. Location of well:	County <u>Reno</u>	Fraction <u>SE 1/4 NW 1/4 NW 1/4</u>	Section number <u>6</u>	Township number <u>T 23 S</u>	Range number <u>R 5 E</u>
2. Distance and direction from nearest town or city: Street address of well location if in city:	<u>807 Newport Rd Hutchinson</u>		3. Owner of well: <u>John Allen</u> R.R. or street: <u>807 Newport Rd</u> City, state, zip code: <u>Hutchinson Kan 67501</u>		
4. Locate with "X" in section below: N W E S 1 Mile			6. Bore hole dia. <u>9</u> in. Completion date <u>4-23-79</u> Well depth <u>38</u> ft.		
5. Type and color of material	From	To	7. <input type="checkbox"/> Cable tool <input type="checkbox"/> Rotary <input type="checkbox"/> Driven <input checked="" type="checkbox"/> Dug <input type="checkbox"/> Hollow rod <input type="checkbox"/> Jetted <input checked="" type="checkbox"/> Bored <input type="checkbox"/> Reverse rotary		
<u>brown sandy soil</u>	<u>0</u>	<u>2</u>	8. Use: <input type="checkbox"/> Domestic <input type="checkbox"/> Public supply <input type="checkbox"/> Industry <input type="checkbox"/> Irrigation <input type="checkbox"/> Air conditioning <input type="checkbox"/> Stock <input checked="" type="checkbox"/> Lawn <input type="checkbox"/> Oil field water <input type="checkbox"/> Other		
<u>brown sandy clay</u>	<u>2</u>	<u>11</u>	9. Casing: Material <u>P105</u> Height: <u>above</u> or below Threading <u>Welded</u> Surface <u>12</u> in. RMP <input checked="" type="checkbox"/> PVC <input type="checkbox"/> Weight <u>614</u> lbs./ft.		
<u>fine sand</u>	<u>11</u>	<u>16</u>	Dia. <u>6</u> in. to <u>38</u> ft. depth Wall Thickness: inches or Dia. <u>6</u> in. to <u>38</u> ft. depth gage No. <u>175</u>		
<u>fine gravel</u>	<u>16</u>	<u>19</u>	10. Screen: Manufacturer's name <u>J&L</u>		
<u>medium gravel</u>	<u>19</u>	<u>38</u>	Type <u>RMP</u> Dia. <u>6"</u> Slot/gauze <u>1/8 hole</u> Length <u>10'</u> Set between <u>28</u> ft. and <u>38</u> ft. Gravel pack? <u>no</u> Size range of material		
			11. Static water level: <u>19</u> ft. below land surface Date <u>4-23-79</u> mo./day/yr.		
			12. Pumping level below land surfaces: <u>20</u> ft. after <u>1</u> hrs. pumping <u>20</u> g.p.m. ft. after <u> </u> hrs. pumping <u> </u> g.p.m. Estimated maximum yield <u>50</u> g.p.m.		
			13. Water sample submitted: <u> </u> mo./day/yr. Yes <input checked="" type="checkbox"/> No <input type="checkbox"/> Date		
			14. Well head completion: <u> </u> Pitless adapter <u>12</u> Inches above grade		
			15. Well grouted? <u>yes</u> With <input checked="" type="checkbox"/> Neat cement <input type="checkbox"/> Bentonite <input type="checkbox"/> Concrete Depth: From <u>3</u> ft. to <u>13</u> ft.		
			16. Nearest source of possible contamination: <u>Solid</u> ft. <u>25</u> Direction <u>W</u> Type <u>sewer</u> Well disinfected upon completion? <input checked="" type="checkbox"/> Yes <input type="checkbox"/> No		
			17. Pump: <u>Not installed</u> Manufacturer's name <u>SFA RITE</u> Model number <u>SP-20</u> HP <u>24</u> Volts <u>220</u> Length of drop pipe <u>30</u> ft. capacity <u>20</u> g.p.m. Type: <input checked="" type="checkbox"/> Submersible <input type="checkbox"/> Turbine <input type="checkbox"/> Jet <input type="checkbox"/> Reciprocating <input type="checkbox"/> Centrifugal <input type="checkbox"/> Other		
18. Elevation:	19. Remarks:		20. Water well contractor's certification: This well was drilled under my jurisdiction and this report is true to the best of my knowledge and belief. <u>Price Water Well 193</u> Business name <u>RR3 Hutchinson</u> License No. <u> </u> Address <u> </u> Signed <u>J. Damond</u> Date <u>6-12-79</u> Authorized representative		

Forward the white, blue and pink copies to the Department of Health and Environment

Form WWC-5