
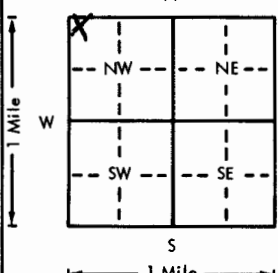


USE TYPEWRITER OR BALL  
POINT PEN—PRESS FIRMLY,  
PRINT CLEARLY.

WATER WELL RECORD  
KSA 82a-1201-1215

Kansas Department of Health and  
Environment—Division of Environment  
(Water well Contractors)  
Topeka, Kansas 66620

|   |  |   |   |   |                                    |  |
|---|--|---|---|---|------------------------------------|--|
| 1. Location of well:  |  | County<br><u>Reno</u>   | Fraction<br><u>NW 1/4 NW 1/4 NW 1/4</u>   | Section number<br><u>6</u>  | Township number<br>T <u>23</u> S R | Range number<br><u>5</u> E W   |
| 2. Distance and direction from nearest town or city:<br>Street address of well location if in city: <u>2900 Acres Rd Hutchinson, Ks.</u>                        |  |   | 3. Owner of well: <u>Virginia Kaegi</u><br>R.R. or street: <u>2765 Tyler</u><br>City, state, zip code: <u>Hutchinson, Ks. 67501</u> |   |                                    |  |
| 4. Locate with "X" in section below:<br>N<br>W<br>E<br>S<br>1 Mile  |  | Sketch map:<br> |   | 6. Bore hole dia. <u>10</u> in. Completion date <u>6-2-76</u><br>Well depth <u>33</u> ft. |                                    |  |
| 5. Type and color of material   |  | From  |   | To  |                                    | 7. <input checked="" type="checkbox"/> Cable tool <input checked="" type="checkbox"/> Rotary <input type="checkbox"/> Driven <input type="checkbox"/> Dug<br><input type="checkbox"/> Hollow rod <input type="checkbox"/> Jetted <input type="checkbox"/> Bored <input type="checkbox"/> Reverse rotary  |
|   |  |   |   |   |                                    | 8. Use: <input type="checkbox"/> Domestic <input type="checkbox"/> Public supply <input type="checkbox"/> Industry<br><input type="checkbox"/> Irrigation <input type="checkbox"/> Air conditioning <input type="checkbox"/> Stock<br><input checked="" type="checkbox"/> Lawn <input type="checkbox"/> Oil field water <input type="checkbox"/> Other   |
|   |  |   |   |   |                                    | 9. Casing: Material <u>PIST</u> Height: <u>Above</u> or below<br>Threaded <input type="checkbox"/> Welded <input type="checkbox"/> Surface <u>12</u> in.<br>RMP <input checked="" type="checkbox"/> PVC <input type="checkbox"/> Weight <u>195</u> lbs./ft.<br>Dia. <u>6</u> in. to <u>33</u> ft. depth Wall Thickness: inches or<br>Dia. <u>  </u> in. to <u>  </u> ft. depth gauge No. <u>200</u>  |
|   |  |   |   |   |                                    | 10. Screen: Manufacturer's name <u>JAL</u><br>Type <u>RMP</u> Dia. <u>6"</u><br>Slot/gauze <u>1/16"</u> Length <u>10'</u><br>Set between <u>23</u> ft. and <u>33</u> ft.<br>ft. and <u>  </u> ft.<br>Gravel pack? <u>yes</u> Size range of material <u>F-1/2"</u>  |
|   |  |   |   |   |                                    | 11. Static water level: <u>21</u> ft. below land surface Date <u>6-2-76</u> mo./day/yr.  |
|   |  |   |   |   |                                    | 12. Pumping level below land surfaces:<br><u>22</u> ft. after <u>5</u> hrs. pumping <u>25</u> g.p.m.<br><u>  </u> ft. after <u>  </u> hrs. pumping <u>  </u> g.p.m.<br>Estimated maximum yield <u>50</u> g.p.m.  |
|   |  |   |   |   |                                    | 13. Water sample submitted: <u>  </u> mo./day/yr.<br><u>  </u> Yes <input checked="" type="checkbox"/> No <u>  </u> Date <u>  </u>   |
|   |  |   |   |   |                                    | 14. Well head completion:<br><u>  </u> Pitless adapter <u>12</u> inches above grade  |
|   |  |   |   |   |                                    | 15. Well grouted? <u>yes</u><br>With: <input checked="" type="checkbox"/> Neat cement <input type="checkbox"/> Bentonite <input type="checkbox"/> Concrete<br>Depth: From <u>0</u> ft. to <u>10</u> ft.  |
|   |  |   |   |   |                                    | 16. Nearest source of possible contamination: <u>Tight</u><br>ft. <u>10</u> Direction <u>W</u> Type <u>Schwenpher</u><br>Well disinfected upon completion? <input checked="" type="checkbox"/> Yes <input type="checkbox"/> No   |
|   |  |   |   |   |                                    | 17. Pump: <input checked="" type="checkbox"/> Not installed<br>Manufacturer's name <u>  </u><br>Model number <u>  </u> HP <u>  </u> Volts <u>  </u><br>Length of drop pipe <u>  </u> ft. capacity <u>  </u> g.p.m.<br>Type:<br><input type="checkbox"/> Submersible <input type="checkbox"/> Turbine<br><input type="checkbox"/> Jet <input type="checkbox"/> Reciprocating<br><input type="checkbox"/> Centrifugal <input type="checkbox"/> Other |
|   |  |   |   |   |                                    | 20. Water well contractor's certification:<br>This well was drilled under my jurisdiction and this report is true to the best of my knowledge and belief.<br><u>Miller Water Well Serv</u> <u>137</u><br>Business name <u>Hutchinson, Ks.</u> License No. <u>  </u><br>Address <u>  </u><br>Signed <u>Joe Miller</u> Date <u>6-26-76</u><br>Authorized representative  |
| 18. Elevation:  |  | 19. Remarks:  |   |   |                                    |  |
| Topography:<br><input type="checkbox"/> Hill<br><input type="checkbox"/> Slope<br><input type="checkbox"/> Upland<br><input checked="" type="checkbox"/> Valley |  |   |   |   |                                    |  |

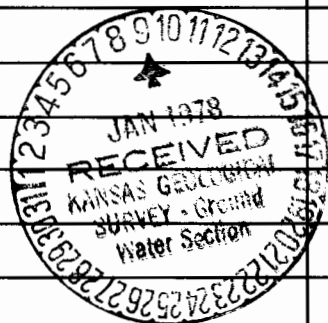

Forward the white, blue and pink copies to the Department of Health and Environment

Form WWC-5