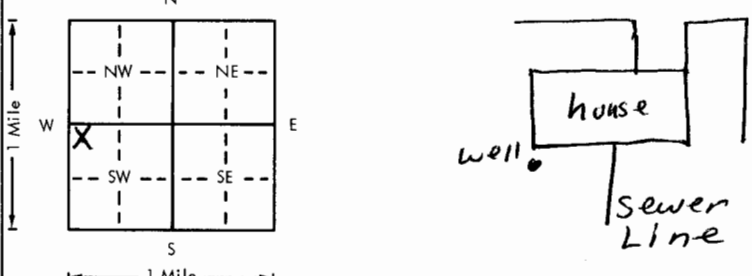


USE TYPEWRITER OR BALL
POINT PEN-PRESS FIRMLY,
PRINT CLEARLY.

WATER WELL RECORD
KSA 82a-1201-1215

Kansas Department of Health and
Environment-Division of Environment
(Water well Contractors)
Topeka, Kansas 66620

1. Location of well:	County <u>Reno</u>	Fraction <u>NW 1/4 NW 1/4 SW 1/4</u>	Section number <u>6</u>	Township number <u>T 23</u>	Range number <u>S R 5</u>	<u>EW</u>
2. Distance and direction from nearest town or city: Street address of well location if in city: <u>501 E. 24th Hutchinson</u>			3. Owner of well: <u>S. L. Clasen</u> R.R. or street: <u>501 E. 24th</u> City, state, zip code: <u>Hutchinson Kan 67501</u>			
4. Locate with "X" in section below: 			6. Bore hole dia. <u>9</u> in. Completion date <u>9-12-77</u> Well depth <u>37</u> ft.			
5. Type and color of material			7. <input type="checkbox"/> Cable tool <input type="checkbox"/> Rotary <input type="checkbox"/> Driven <input checked="" type="checkbox"/> Dug <input type="checkbox"/> Hollow rod <input type="checkbox"/> Jetted <input checked="" type="checkbox"/> Bored <input type="checkbox"/> Reverse rotary			
brown sandy soil			8. Use: <input type="checkbox"/> Domestic <input type="checkbox"/> Public supply <input type="checkbox"/> Industry <input type="checkbox"/> Irrigation <input type="checkbox"/> Air conditioning <input type="checkbox"/> Stock <input checked="" type="checkbox"/> Lawn <input type="checkbox"/> Oil field water <input type="checkbox"/> Other			
brown sandy clay			9. Casing: Material <u>Plas</u> Height: <u>Above</u> or below Threaded <input type="checkbox"/> Welded <u>Glue</u> Surface <u>12</u> in. RMP <input checked="" type="checkbox"/> PVC <input type="checkbox"/> Weight <u>175</u> lbs./ft.			
fine sand			Dia. <u>6</u> in. to <u>37</u> ft. depth Wall Thickness: inches or Dia. <u>1</u> in. to <u>37</u> ft. depth gage No. <u>1175</u>			
fine gravel			10. Screen: Manufacturer's name <u>J&L</u>			
medium gravel			Type <u>RMP</u> Dia. <u>6"</u> Slot/gauze <u>1/8 hole</u> Length <u>10'</u> Set between <u>27</u> ft. and <u>37</u> ft. Gravel pack? <u>NO</u> Size range of material <u> </u>			
			11. Static water level: <u>18</u> ft. below land surface Date <u>9-12-77</u>			
			12. Pumping level below land surfaces: <u>18 1/2</u> ft. after <u>1</u> hrs. pumping <u>20</u> g.p.m. ____ ft. after ____ hrs. pumping ____ g.p.m. Estimated maximum yield <u>75</u> g.p.m.			
			13. Water sample submitted: <u> </u> mo./day/yr. <input type="checkbox"/> Yes <input checked="" type="checkbox"/> No Date <u> </u>			
			14. Well head completion: <input type="checkbox"/> Pitless adapter <u>12</u> inches above grade			
			15. Well grouted? <u>yes</u> With: <input checked="" type="checkbox"/> Neat cement <input type="checkbox"/> Bentonite <input type="checkbox"/> Concrete Depth: From <u>3</u> ft. to <u>13</u> ft.			
			16. Nearest source of possible contamination: <u>Solid</u> ft. <u>20</u> Direction <u>E</u> Type <u>Sewer</u> Well disinfected upon completion? <input checked="" type="checkbox"/> Yes <input type="checkbox"/> No			
			17. Pump: <u>Not installed</u> Manufacturer's name <u>STA RITE</u> Model number <u>Ser 20</u> HP <u>1/2</u> Volts <u>230</u> Length of drop pipe <u>25</u> ft. capacity <u>20</u> g.p.m. Type: <input checked="" type="checkbox"/> Submersible <input type="checkbox"/> Turbine <input type="checkbox"/> Jet <input type="checkbox"/> Reciprocating <input type="checkbox"/> Centrifugal <input type="checkbox"/> Other			
18. Elevation:			19. Remarks:			
Topography: <input type="checkbox"/> Hill <input type="checkbox"/> Slope <input type="checkbox"/> Upland <input checked="" type="checkbox"/> Valley			20. Water well contractor's certification: This well was drilled under my jurisdiction and this report is true to the best of my knowledge and belief. <u>Price Water well 193</u> Business name <u>RR3 Hutchinson</u> License No. <u> </u> Address <u>John Davenport</u> Date <u>6-25-78</u> Signed <u> </u> Authorized representative			

Forward the white, blue and pink copies to the Department of Health and Environment

Form WWC-5