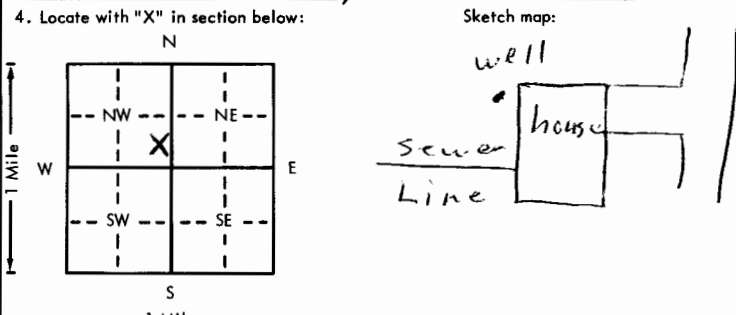


USE TYPEWRITER OR BALL  
POINT PEN-PRESS FIRMLY,  
PRINT CLEARLY.

WATER WELL RECORD  
KSA 82a-1201-1215

Kansas Department of Health and  
Environment-Division of Environment  
(Water well Contractors)  
Topeka, Kansas 66620

1. Location of well:	County <u>Reno</u>	Fraction <u>E 1/4 SE 1/4 NW 1/4</u>	Section number <u>6</u>	Township number <u>T 23 S</u>	Range number <u>R 5 E</u>
2. Distance and direction from nearest town or city: Street address of well location if in city: <u>2407 Colorado Hutchinson</u>			3. Owner of well: <u>Boyd Higgins</u> R.R. or street: <u>2407 Colorado</u> City, state, zip code: <u>Hutchinson Kan. 67501</u>		
4. Locate with "X" in section below: 			6. Bore hole dia. <u>9</u> in. Completion date <u>4-22-75</u> Well depth <u>35</u> ft.		
5. Type and color of material			7. <u>  </u> Cable tool <u>  </u> Rotary <u>  </u> Driven <u>X</u> Dug <u>  </u> Hollow rod <u>  </u> Jetted <u>X</u> Bored <u>  </u> Reverse rotary		
brown top soil			8. Use: <u>  </u> Domestic <u>  </u> Public supply <u>  </u> Industry <u>  </u> Irrigation <u>  </u> Air conditioning <u>  </u> Stock <u>X</u> Lawn <u>  </u> Oil field water <u>  </u> Other		
brown sandy clay			9. Casing: Material <u>PLEX</u> Height: <u>Above</u> or below Threaded <u>  </u> Welded <u>GLUE</u> Surface <u>12</u> in. RMP <u>X</u> PVC <u>  </u> Weight <u>  </u> lbs./ft. Dia. <u>6</u> in. to <u>35</u> ft. depth Wall Thickness: inches or Dia. <u>  </u> in. to <u>  </u> ft. depth gage No. <u>175</u>		
grey clay			10. Screen: Manufacturer's name <u>JEL</u> Type <u>RMP</u> Dia. <u>6"</u> Slot/gauze <u>1/8 hole</u> Length <u>10'</u> Set between <u>25</u> ft. and <u>35</u> ft. <u>  </u> ft. and <u>  </u> ft. Gravel pack? <u>NO</u> Size range of material <u>  </u>		
brown sandy clay			11. Static water level: <u>22</u> ft. below land surface Date <u>4-22-75</u>		
fine gravel			12. Pumping level below land surfaces: <u>22 1/2</u> ft. after <u>1</u> hrs. pumping <u>30</u> g.p.m. <u>  </u> ft. after <u>  </u> hrs. pumping <u>  </u> g.p.m. Estimated maximum yield <u>25</u> g.p.m.		
medium gravel			13. Water sample submitted: <u>  </u> mo./day/yr. <u>  </u> Yes <u>X</u> No Date <u>  </u>		
			14. Well head completion: <u>  </u> Pitless adapter <u>12</u> Inches above grade		
			15. Well grouted? <u>yes</u> With: <u>  </u> Neat cement <u>  </u> Bentonite <u>X</u> Concrete Depth: From <u>3</u> ft. to <u>13</u> ft.		
			16. Nearest source of possible contamination: <u>Solid</u> ft. <u>20</u> Direction <u>S</u> Type <u>sewer</u> Well disinfected upon completion? <u>  </u> Yes <u>X</u> No		
			17. Pump: <u>X</u> Not installed Manufacturer's name <u>  </u> Model number <u>  </u> HP <u>  </u> Volts <u>  </u> Length of drop pipe <u>  </u> ft. capacity <u>  </u> g.p.m. Type: <u>  </u> Submersible <u>  </u> Turbine <u>  </u> Jet <u>  </u> Reciprocating <u>  </u> Centrifugal <u>  </u> Other		
18. Elevation:			20. Water well contractor's certification: This well was drilled under my jurisdiction and this report is true to the best of my knowledge and belief. <u>Price Water well 193</u> Business name <u>RR3 Hutch</u> License No. <u>  </u> Address <u>John Davenport</u> Signed <u>  </u> Date <u>8-10-75</u> Authorized representative		
19. Remarks:  Topography: <u>  </u> Hill <u>  </u> Slope <u>  </u> Upland <u>X</u> Valley					

Forward the white, blue and pink copies to the Department of Health and Environment

Form WWC-5