


1 LOCATION OF WATER WELL: County: <i>Reno</i>	Fraction <i>NW 1/4 NE 1/4 NW 1/4</i>	Section Number <i>6</i>	Township Number T <i>23</i> S	Range Number R <i>5</i> E <i>W</i>
--	---	----------------------------	----------------------------------	---------------------------------------

Distance and direction from nearest town or city street address of well if located within city?
 2900 Acres Rd Hutchinson KS NW 15

2 WATER WELL OWNER: *Vizkers Service station*
RR#, St. Address, Box # : *207 E 30th*

3 LOCATE WELL'S LOCATION WITH AN "X" IN SECTION BOX: 4 DEPTH OF COMPLETED WELL. 30 ft. ELEVATION: 17

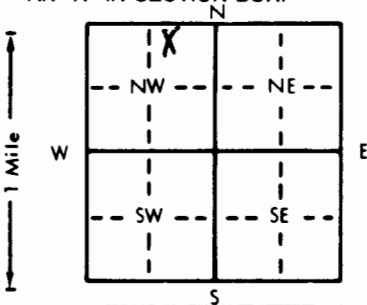

4 DEPTH OF COMPLETED WELL. 30 ft. ELEVATION: _____

Depth(s) Groundwater Encountered 1. 17 ft. 2. _____ ft. 3. _____ ft.

WELL'S STATIC WATER LEVEL 17.36 ft. below land surface measured on mo/day/yr 8/12/88

Pump test data: Well water was _____ ft. after _____ hours pumping _____ gpm

Est. Yield _____ gpm: Well water was _____ ft. after _____ hours pumping _____ gpm

Bore Hole Diameter. 11 in. to 30 ft., and _____ in. to _____ ft.

WELL WATER TO BE USED AS:

1 Domestic	3 Feedlot	6 Oil field water supply	8 Air conditioning	11 Injection well
2 Irrigation	4 Industrial	7 Lawn and garden only	9 Dewatering	12 Other (Specify below)

_____ 10 Monitoring well

Was a chemical/bacteriological sample submitted to Department? Yes _____ No X _____; If yes, mo/day/yr sample was submitted _____

Water Well Disinfected? Yes _____ No X _____

5 TYPE OF BLANK CASING USED:		5 Wrought iron	8 Concrete tile	CASING JOINTS: Glued Clamped	
1 Steel	3 RMP (SR)	6 Asbestos-Cement	9 Other (specify below)	Welded	
② PVC	4 ABS	7 Fiberglass		Threaded. X	
Blank casing diameter 4 in. to 15 ft, Dia			 in. to ft, Dia	

Casing height above land surface. 3 in., weight _____ lbs./ft. Wall thickness or gauge No. 5-6 40

TYPE OF SCREEN OR PERFORATION MATERIAL: ① PVC 10 Asbestos-cement

1 Steel	3 Stainless steel	5 Fiberglass	8 RMP (SR)	11 Other (specify) _____
2 Brass	4 Galvanized steel	6 Concrete tile	9 ABS	12 None used (open hole)

SCREEN OR PERFORATION OPENINGS ARE:

1 Continuous slot	3 Mill slot	5 Gauzed wrapped	8 Saw cut	11 None (open hole)
2 Louvered shutter	4 Key punched	6 Wire wrapped	9 Drilled holes	
		7 Torch cut	10 Other (specify)	

SCREEN-PERFORATED INTERVALS:	From	13	ft. to	30	ft., From		ft. to		ft.
	From		ft. to		ft., From		ft. to		ft.
GRAVEL PACK INTERVALS:	From	10	ft. to	25	ft., From		ft. to		ft.
	From		ft. to		ft., From		ft. to		ft.

6 GROUT MATERIAL: 1 Neat cement 2 Cement grout 3 Bentonite 4 Other
Grout intervals: From Surface ft. to 10 ft., From _____ ft. to _____ ft., From _____ ft. to _____ ft.

What is the nearest source of possible contamination:

1 Septic tank	4 Lateral lines	7 Pit privy	10 Livestock pens	14 Abandoned water well
2 Sewer lines	5 Cess pool	8 Sewage lagoon	<input checked="" type="radio"/> Fuel storage	15 Oil well/Gas well
3 Watertight sewer lines	6 Seepage pit	9 Feedyard	12 Fertilizer storage	16 Other (specify below)
Direction from well?		<i>NW</i>	13 Insecticide storage	
			How many feet?	<i>300</i>

LITHOLOGIC LOG		PLUGGING INTERVALS	
FROM	TO	FROM	TO
0	2		
2	9		
9	13		
13	18		
18	20		
20	30		
GROUT Variance			
grouted 8/18/88			

7 CONTRACTOR'S OR LANDOWNER'S CERTIFICATION: This water well was (1) constructed, (2) reconstructed, or (3) plugged under my jurisdiction and was completed on (mo/day/year) 8/11/88 and this record is true to the best of my knowledge and belief. Kansas Water Well Contractor's License No. 415 This Water Well Record was completed on (mo/day/yr) 8-19-88 under the business name of Daniel Prill by (signature) Daniel Prill