

WATER WELL RECORD Form WWC-5


Division of Water Resources App. No.

Well ID RP093

Original Record Correction Change in Well Use

1 LOCATION OF WATER WELL: County: <u>Reno</u>	Fraction NE ¼ SE ¼ NE ¼ SE ¼	Section Number <u>13</u>	Township Number T <u>23</u> S	Range Number R <u>5</u> <input type="checkbox"/> E <input checked="" type="checkbox"/> W
---	---------------------------------	-----------------------------	----------------------------------	---

2 WELL OWNER: Last Name: <u>Shinn</u> First: <u>David</u> Business Address: <u>7302 East Zolman</u> Address: _____ City: <u>Hutchinson</u> State: <u>Ks.</u> ZIP: <u>67501</u>	Street or Rural Address where well is located (if unknown, distance and direction from nearest town or intersection): If at owner's address, check here: <input checked="" type="checkbox"/>
--	--

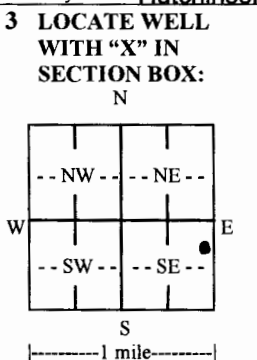

4 DEPTH OF COMPLETED WELL: 34 ft.

Depth(s) Groundwater Encountered: 1) ft.
 2) ft. 3) ft., or 4) Dry Well

WELL'S STATIC WATER LEVEL: 12 ft.

below land surface, measured on (mo-day-yr) 12/12/2018
 above land surface, measured on (mo-day-yr)

Pump test data: Well water was ft.
 after hours pumping gpm
 Well water was ft.
 after hours pumping gpm

Estimated Yield: gpm
 Bore Hole Diameter: 1 1/2 in. to 34 ft. and
 in. to ft.

5 Latitude: 38.04821 (decimal degrees)
Longitude: 097.81224 (decimal degrees)
 Horizontal Datum: WGS 84 NAD 83 NAD 27
 Source for Latitude/Longitude:
 GPS (unit make/model: Garmin 62S)
 (WAAS enabled? Yes No)
 Land Survey Topographic Map
 Online Mapper:

6 Elevation: 1496 ft. Ground Level TOC
 Source: Land Survey GPS Topographic Map
 Other

7 WELL WATER TO BE USED AS:

1. Domestic: <input checked="" type="checkbox"/> Household <input type="checkbox"/> Lawn & Garden <input type="checkbox"/> Livestock 2. <input type="checkbox"/> Irrigation 3. <input type="checkbox"/> Feedlot 4. <input type="checkbox"/> Industrial	5. <input type="checkbox"/> Public Water Supply: well ID	10. <input type="checkbox"/> Oil Field Water Supply: lease
6. <input type="checkbox"/> Dewatering: how many wells?	7. <input type="checkbox"/> Aquifer Recharge: well ID	11. Test Hole: well ID
8. <input type="checkbox"/> Monitoring: well ID	9. Environmental Remediation: well ID	12. Geothermal: how many bores?
<input type="checkbox"/> Air Sparge <input type="checkbox"/> Soil Vapor Extraction <input type="checkbox"/> Recovery <input type="checkbox"/> Injection	13. <input type="checkbox"/> Other (specify):	a) Closed Loop <input type="checkbox"/> Horizontal <input type="checkbox"/> Vertical b) Open Loop <input type="checkbox"/> Surface Discharge <input type="checkbox"/> Inj. of Water

Was a chemical/bacteriological sample submitted to KDHE? Yes No If yes, date sample was submitted:

Water well disinfected? Yes No

8 TYPE OF CASING USED: Steel PVC Other CASING JOINTS: Glued Clamped Welded Threaded
 Casing diameter 5 in. to 24 ft., Diameter in. to ft., Diameter in. to ft.
 Casing height above land surface 24 in. Weight 160 lbs./ft. Wall thickness or gauge No. 214

TYPE OF SCREEN OR PERFORATION MATERIAL:
 Steel Stainless Steel Fiberglass PVC Other (Specify)

Brass Galvanized Steel Concrete tile None used (open hole)

SCREEN OR PERFORATION OPENINGS ARE:
 Continuous Slot Mill Slot Gauze Wrapped Torch Cut Drilled Holes Other (Specify)

Louvered Shutter Key Punched Wire Wrapped Saw Cut None (Open Hole)

SCREEN-PERFORATED INTERVALS: From 24 ft. to 34 ft., From ft. to ft., From ft. to ft.
 GRAVEL PACK INTERVALS: From 34 ft. to 18 ft., From ft. to ft., From ft. to ft.

9 GROUT MATERIAL: Neat cement Cement grout Bentonite Other

Grout Intervals: From 18 ft. to 0 ft., From ft. to ft., From ft. to ft.

Nearest source of possible contamination:
 Septic Tank Lateral Lines Pit Privy Livestock Pens Insecticide Storage
 Sewer Lines Cess Pool Sewage Lagoon Fuel Storage Abandoned Water Well
 Watertight Sewer Lines Seepage Pit Feedyard Fertilizer Storage Oil Well/Gas Well
 Other (Specify)

Direction from well? West Distance from well? 105 ft.

10 FROM	TO	LITHOLOGIC LOG	FROM	TO	LITHO. LOG (cont.) or PLUGGING INTERVALS
0	3	Top soil			
3	5	Tan clay			
5	11	Light gray clay			
11	30	Med. sand & gravel			
30	34	Shale			

Notes:

11 CONTRACTOR'S OR LANDOWNER'S CERTIFICATION: This water well was constructed, reconstructed, or plugged under my jurisdiction and was completed on (mo-day-year) 12/12/2018 and this record is true to the best of my knowledge and belief. Kansas Water Well Contractor's License No. 134 This Water Well Record was completed on (mo-day-year) 12/17/2018 under the business name of Rosencrantz-Bemis Enl. Signature C. J. Sumrell