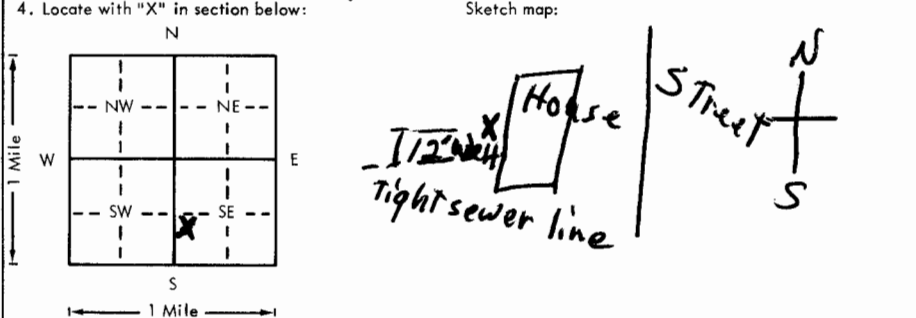


USE TYPEWRITER OR BALL  
POINT PEN-PRESS FIRMLY,  
PRINT CLEARLY.

WATER WELL RECORD  
KSA 82a-1201-1215

Kansas Department of Health and  
Environment-Division of Environment  
(Water well Contractors)  
Topeka, Kansas 66620

1. Location of well:		County <b>Reno</b>	Fraction <b>NW 1/4 SW 1/4 SE 1/4</b>	Section number <b>8</b>	Township number <b>T 23 S R 5 E/W</b>	Range number <b>5</b>
2. Distance and direction from nearest town or city: Street address of well location if in city: <b>613 N Grandview Hutchinson</b>			3. Owner of well: <b>Mrs. Hawn</b> R.R. or street: City, state, zip code: <b>613 N Grandview Hutchinson, KS</b>			
4. Locate with "X" in section below: 			6. Bore hole dia. <b>10</b> in. Completion date: <b>4-17-78</b> Well depth <b>39</b> ft.			
5. Type and color of material			7. <input checked="" type="checkbox"/> Cable tool <input checked="" type="checkbox"/> Rotary <input type="checkbox"/> Driven <input type="checkbox"/> Dug <input type="checkbox"/> Hollow rod <input type="checkbox"/> Jetted <input type="checkbox"/> Bored <input type="checkbox"/> Reverse rotary			
Topsoil			8. Use: <input type="checkbox"/> Domestic <input type="checkbox"/> Public supply <input type="checkbox"/> Industry <input type="checkbox"/> Irrigation <input type="checkbox"/> Air conditioning <input type="checkbox"/> Stock <input checked="" type="checkbox"/> Lawn <input type="checkbox"/> Oil field water <input type="checkbox"/> Other			
Silt			9. Casing: Material <b>Plst</b> Height <b>Above</b> or below Threaded <input type="checkbox"/> Welded <input type="checkbox"/> Surface <b>12</b> in. RMP <input checked="" type="checkbox"/> PVC <input type="checkbox"/> Weight <b>1.95</b> lbs./ft. Dia. <b>6</b> in. to <b>39</b> ft. depth Wall thickness: inches or Dia. <b>6</b> in. to <b>39</b> ft. depth gage No. <b>200</b>			
Sand - coarse			10. Screen: Manufacturer's name <b>Sunflower</b> Type <b>RMP</b> Dia. <b>6</b> Slot gauze <b>.060</b> Length <b>10</b> Set between <b>28</b> ft. and <b>38</b> ft. ft. and <b>38</b> ft. Gravel pack? <b>yes</b> Size range of material <b>F-12</b>			
black peat			11. Static water level: <b>19</b> ft. below land surface Date <b>4-17-78</b>			
Sand + gravel			12. Pumping level below land surfaces: <b>20</b> ft. after <b>1</b> hrs. pumping <b>20</b> g.p.m. ft. after <b>1</b> hrs. pumping <b>20</b> g.p.m. Estimated maximum yield <b>50+</b> g.p.m.			
			13. Water sample submitted: <b>no./day/yr.</b> <input type="checkbox"/> Yes <input checked="" type="checkbox"/> No Date			
			14. Well head completion: <input type="checkbox"/> Pitless adapter <b>12</b> Inches above grade			
			15. Well grouted? <b>yes</b> With: <input checked="" type="checkbox"/> Neat cement <input type="checkbox"/> Bentonite <input type="checkbox"/> Concrete Depth: From <b>0</b> ft. to <b>10</b> ft.			
			16. Nearest source of possible contamination: <b>Tight Sewer</b> ft. <b>12</b> Direction <b>S</b> Type <b>Sewer</b> Well disinfected upon completion? <input checked="" type="checkbox"/> Yes <input type="checkbox"/> No			
			17. Pump: <input checked="" type="checkbox"/> Not installed Manufacturer's name Model number <b>HP</b> <b>Volts</b> Length of drop pipe <b>ft.</b> capacity <b>g.p.m.</b> Type: <input type="checkbox"/> Submersible <input type="checkbox"/> Turbine <input type="checkbox"/> Jet <input type="checkbox"/> Reciprocating <input type="checkbox"/> Centrifugal <input type="checkbox"/> Other			
			(Use a second sheet if needed)			
18. Elevation:		19. Remarks:		20. Water well contractor's certification: This well was drilled under my jurisdiction and this report is true to the best of my knowledge and belief. <b>Miller Water Well</b> <b>137</b> Business name <b>Hutchinson, KS</b> License No. Address <b>613 N Grandview</b> Signed <b>Joe Miller</b> Date <b>4-17-78</b> Authorized representative		
Topography: <input type="checkbox"/> Hill <input type="checkbox"/> Slope <input type="checkbox"/> Upland <input checked="" type="checkbox"/> Valley						

Forward the white, blue and pink copies to the Department of Health and Environment

Form WWC-5