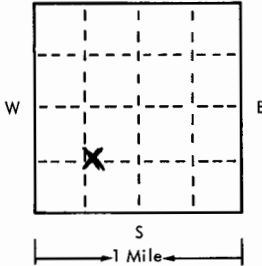
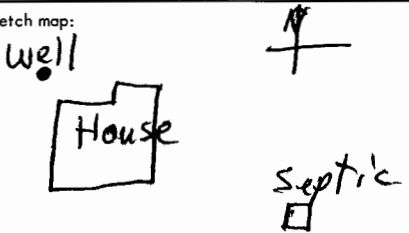


USE TYPEWRITER OR BALL
POINT PEN—PRESS FIRMLY,
PRINT CLEARLY.

WATER WELL RECORD
KSA 82a-1201-1215

called 4/21/05 1
T R EW sec 1/4 1/4 1/4 No.

Kansas State Dept. Of Health
(Water Well Contractors)
Forbes-Bldg. 740
Topeka, Kansas 66620

1 Location of well:	County RENO	Township name CLAY	Fraction SWNESW	Section number 11	Town number T23S	Range number R5W
Distance and direction from nearest town or city: 1 mi E Hutchinson City limits				3 Owner of well: Dan Frank Address: 18 Faircrest Hutchinson KS		
Locate with "X" in section below: 		Sketch map: 		4 Well depth: 28 ft. Date of completion 3-6-75 Well diameter 10 in.		
2 Type and color of material		From To		5 <input type="checkbox"/> Cable tool <input checked="" type="checkbox"/> Rotary <input type="checkbox"/> Driven <input type="checkbox"/> Dug <input type="checkbox"/> Hollow rod <input type="checkbox"/> Jetted <input type="checkbox"/> Bored <input type="checkbox"/> Reverse rotary		
				6 Use: <input checked="" type="checkbox"/> Domestic <input type="checkbox"/> Public supply <input type="checkbox"/> Industry <input type="checkbox"/> Irrigation <input type="checkbox"/> Air conditioning <input type="checkbox"/> Commercial <input type="checkbox"/> Test well <input type="checkbox"/>		
				7 Casing: Material synch <input type="checkbox"/> Right above/below Threaded <input type="checkbox"/> Welded <input type="checkbox"/> Surface 10 in. Diam. 6 in. to 28 ft. depth Drive shoe? <input type="checkbox"/> Yes <input checked="" type="checkbox"/> No 6 in. to 28 ft. depth		
				8 Screen: Manufacturer Sunflower Type slot plastic 6" Slot/gauze 3/32 Length 6' Set between 22 ft. and 28 ft. Fittings: 1/2-3/8" 8 Gravel pack <input checked="" type="checkbox"/> Yes <input type="checkbox"/> No Size range of material 8		
				9 Static water level: 16 ft. below land surface Date 3-6-75		
(use a second sheet if needed)				10 Pumping level below land surfaces: 18 ft. after 1 hrs. pumping 20 g.p.m. 18 ft. after 1 hrs. pumping 20 g.p.m. Estimated maximum yield 40 g.p.m.		
				11 Water sample submitted: <input type="checkbox"/> Yes <input checked="" type="checkbox"/> No Date 3-6-75		
				12 Well head completion: 12" <input checked="" type="checkbox"/> Pitless adapter <input checked="" type="checkbox"/> Inches above grade		
				13 Well grouted? <input checked="" type="checkbox"/> Yes <input type="checkbox"/> No <input checked="" type="checkbox"/> Neat cement <input type="checkbox"/> Bentonite <input type="checkbox"/> Depth: From 4 ft. to 14 ft.		
				14 Nearest source of possible contamination: ft. 100 Direction SE Type septic Well disinfected upon completion? <input checked="" type="checkbox"/> Yes <input type="checkbox"/> No		
16 Remarks: elevation well location is 1/2 mi SE of former City of Hutchinson sanitary landfill				15 Pump: Manufacturer's name Aeromotor <input type="checkbox"/> Not installed Model number SDR HP 1/2 Volts 220 Length of drop pipe 20 ft. capacity 12 g.p.m. Type: <input checked="" type="checkbox"/> Submersible <input type="checkbox"/> Turbine <input type="checkbox"/> Jet <input type="checkbox"/> Reciprocating <input type="checkbox"/> Centrifugal <input type="checkbox"/> Other		
				17 Water well contractor's certification: This well was drilled under my jurisdiction and this report is true to the best of my knowledge and belief. Miller Waterwell 137 Business name Hutchinson, Ks. License No. Address Joe Miller Date 3-6-75 Signed Joe Miller Authorized representative		

Forward the white, blue and pink copies to the Kansas State Dept. Of Health.

Form WWC-5