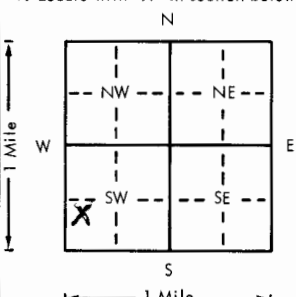
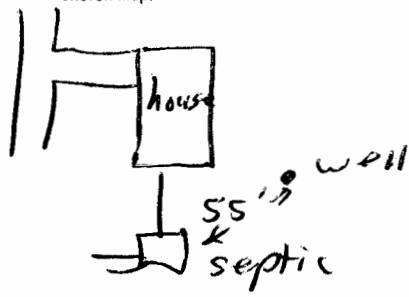


USE TYPEWRITER OR BALL
POINT PEN-PRESS FIRMLY,
PRINT CLEARLY.

WATER WELL RECORD
KSA 82a-1201-1215

Kansas Department of Health and
Environment-Division of Environment
(Water well Contractors)
Topeka, Kansas 66620

1. Location of well:		County Reno	Fraction NW 1/4 SW 1/4 SW 1/4	Section number 11	Township number T 23 S	Range number R 5 E 10
2. Distance and direction from nearest town or city: Street address of well location if in city: 700 N Obee Rd Hutchinson		3. Owner of well: Marvin Wambsganss R.R. or street: 700 N. Obee Rd City, state, zip code: Hutchinson Kan 67501				
4. Locate with "X" in section below: 		Sketch map: 		6. Bore hole dia. 9 in. Completion date 5-16-78 Well depth 38 ft.		
5. Type and color of material		From	To	7. <input type="checkbox"/> Cable tool <input type="checkbox"/> Rotary <input type="checkbox"/> Driven <input checked="" type="checkbox"/> Dug <input type="checkbox"/> Hollow rod <input type="checkbox"/> Jetted <input checked="" type="checkbox"/> Bored <input type="checkbox"/> Reverse rotary		
brown sandy soil		0	3	8. Use: <input type="checkbox"/> Domestic <input type="checkbox"/> Public supply <input type="checkbox"/> Industry <input type="checkbox"/> Irrigation <input checked="" type="checkbox"/> Air conditioning <input type="checkbox"/> Stock <input type="checkbox"/> Lawn <input type="checkbox"/> Oil field water <input type="checkbox"/> Other		
brown sandy clay		3	7	9. Casing: Material Plas Height: Above or below Threaded <input type="checkbox"/> Welded 6 Surface 12 in. RMP <input checked="" type="checkbox"/> PVC <input type="checkbox"/> Weight <input type="checkbox"/> lbs./ft.		
fine sand		7	9	Dia. 6 in. to 38 ft. depth Wall Thickness: inches or Dia. <input type="checkbox"/> in. to <input type="checkbox"/> ft. depth Gage No. 1175		
fine gravel		9	13	10. Screen: Manufacturer's name J & L Type RMP Dia. 6" Slot/gauze 1/8 hole Length 10' Set between 28 ft. and 38 ft. ft. and <input type="checkbox"/> ft.		
medium gravel		13	38	Gravel pack? NO Size range of material <input type="checkbox"/>		
				11. Static water level: <input type="checkbox"/> ft. below land surface Date 5-16-78 mo./day/yr.		
				12. Pumping level below land surfaces: 17 1/2 ft. after 1 hrs. pumping 15 g.p.m. ft. after <input type="checkbox"/> hrs. pumping <input type="checkbox"/> g.p.m. Estimated maximum yield 50 g.p.m.		
				13. Water sample submitted: <input type="checkbox"/> Yes <input checked="" type="checkbox"/> No Date <input type="checkbox"/>		
				14. Well head completion: <input type="checkbox"/> Pitless adapter 12 inches above grade		
				15. Well grouted? yes With: <input checked="" type="checkbox"/> Neat cement <input type="checkbox"/> Bentonite <input type="checkbox"/> Concrete Depth: From 3 ft. to 13 ft.		
				16. Nearest source of possible contamination: ft. 55 Direction SW Type septic Well disinfected upon completion? <input checked="" type="checkbox"/> Yes <input type="checkbox"/> No		
				17. Pump: <input checked="" type="checkbox"/> Not installed Manufacturer's name <input type="checkbox"/> Model number <input type="checkbox"/> HP <input type="checkbox"/> Volts <input type="checkbox"/> Length of drop pipe <input type="checkbox"/> ft. capacity <input type="checkbox"/> g.p.m. Type: <input type="checkbox"/> Submersible <input type="checkbox"/> Turbine <input type="checkbox"/> Jet <input type="checkbox"/> Reciprocating <input type="checkbox"/> Centrifugal <input type="checkbox"/> Other		
18. Elevation:		19. Remarks: will be used for heat pump but unit not in yet.		20. Water well contractor's certification: This well was drilled under my jurisdiction and this report is true to the best of my knowledge and belief. Price Water Well 193 Business name RR3 Hutchinson License No. <input type="checkbox"/> Address RR3 Hutchinson Signed John Davern Date 6-20-78 Authorized representative		

Forward the white, blue and pink copies to the Department of Health and Environment

Form WWC-5