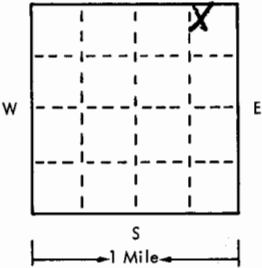
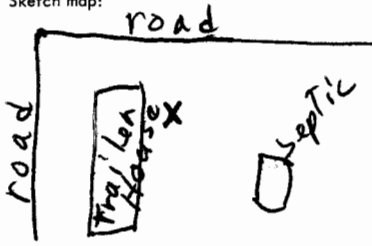


USE TYPEWRITER OR BALL
POINT PEN-PRESS FIRMLY,
PRINT CLEARLY.

WATER WELL RECORD
KSA 82a-1201-1215

T R EW sec 1/4 1/4 1/4 No.

Kansas State Dept. Of Health
(Water Well Contractors)
Forbes-Bldg. 740
Topeka, Kansas 66620

1 Location of well:	County RENO	Township name Clay	Fraction NWNE	Section number 11	Town number T-23-S	Range number R5W			
Distance and direction from nearest town or city: 3 mi East of Hutchinson, Ks				3 Owner of well: Robt. W. McCullough Address: 1698 Barnes LK Rd, Hutchinson, Ks					
Locate with "X" in section below: 		Sketch map: 		4 Well depth: 44 ft. Date of completion: 7-18-75 Well diameter: 10 in.					
2		Type and color of material		From		To		5 <input type="checkbox"/> Cable tool <input checked="" type="checkbox"/> Rotary <input type="checkbox"/> Driven <input type="checkbox"/> Dug <input type="checkbox"/> Hollow rod <input type="checkbox"/> Jetted <input type="checkbox"/> Bored <input type="checkbox"/> Reverse rotary	
								6 Use: <input checked="" type="checkbox"/> Domestic <input type="checkbox"/> Public supply <input type="checkbox"/> Industry <input type="checkbox"/> Irrigation <input type="checkbox"/> Air conditioning <input type="checkbox"/> Commercial <input type="checkbox"/> Test well <input type="checkbox"/>	
								7 Casing: Material PVC Height: above below Threaded <input type="checkbox"/> Welded <input type="checkbox"/> Surface 24" Diam. 6 in. to 44 ft. depth Drive shoe? <input type="checkbox"/> Yes <input checked="" type="checkbox"/> No	
								8 Screen: Manufacturer Jess & Lowell Type AMP Dia. 6" Slot/gauze 3/16" Length 1.5' Set between 29 ft. and 44 ft. Fittings: no gravel Gravel pack <input checked="" type="checkbox"/> Yes <input type="checkbox"/> No Size range of material	
								9 Static water level: 4 ft. below land surface Date 7-18-75	
								10 Pumping level below land surfaces: 35 ft. after 1 hrs. pumping 20 g.p.m. ft. after hrs. pumping g.p.m. Estimated maximum yield 25 g.p.m.	
								11 Water sample submitted: <input type="checkbox"/> Yes <input checked="" type="checkbox"/> No Date	
								12 Well head completion: <input type="checkbox"/> Pitless adapter <input checked="" type="checkbox"/> Inches above grade	
								13 Well grouted? <input checked="" type="checkbox"/> Yes <input type="checkbox"/> No <input checked="" type="checkbox"/> Neat cement <input type="checkbox"/> Bentonite Depth: From 0 ft. to 10 ft.	
								14 Nearest source of possible contamination: ft. 60 Direction East Type Septic Well disinfected upon completion? <input checked="" type="checkbox"/> Yes <input type="checkbox"/> No	
								15 Pump: Manufacturer's name Aermotor Model number BUC HP 3/4 Volts 115 Length of drop pipe 35 ft. capacity 15 g.p.m. Type: <input type="checkbox"/> Submersible <input type="checkbox"/> Turbine <input checked="" type="checkbox"/> Jet <input type="checkbox"/> Reciprocating <input type="checkbox"/> Centrifugal <input type="checkbox"/> Other	
								16 Remarks: elevation	
								17 Water well contractor's certification: This well was drilled under my jurisdiction and this report is true to the best of my knowledge and belief. Miller Water Well Serv. 137 Business name Hutchinson, Ks License No. Address Joe Miller Date 7-18-75 Signed Joe Miller Authorized representative	

Forward the white, blue and pink copies to the Kansas State Dept. Of Health.

Form WWC-5