


1 LOCATION OF WATER WELL: County: Reno Fraction: NE 1/4 NE 1/4 SE 1/4 Section Number: 12 Township Number: T 23 S Range Number: R 5 E

Distance and direction from nearest town or city street address of well if located within city?

1301 Kent Rd Hutchinson Kan.

2 WATER WELL OWNER: Jayhawk Realty
 RR#, St. Address, Box #: 510 E. 17th
 City, State, ZIP Code: Hutchinson Kan. 67502
 Board of Agriculture, Division of Water Resources
 Application Number:

3 LOCATE WELL'S LOCATION WITH AN "X" IN SECTION BOX:

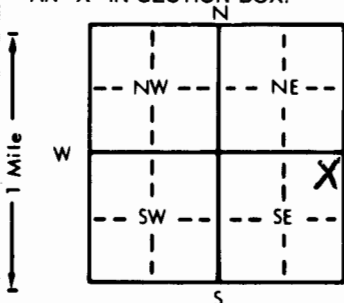

4 DEPTH OF COMPLETED WELL: 102 ft. ELEVATION:

Depth(s) Groundwater Encountered 1. 19 ft. 2. 19 ft. 3. 19 ft.

WELL'S STATIC WATER LEVEL 19 ft. below land surface measured on mo/day/yr 6-18-85

Pump test data: Well water was 34 ft. after 1 hours pumping 15 gpm

Est. Yield 20 gpm Well water was 34 ft. after 1 hours pumping 15 gpm

Bore Hole Diameter 12 in. to 102 ft., and 102 in. to 102 ft.

WELL WATER TO BE USED AS: 5 Public water supply 8 Air conditioning 11 Injection well

1 Domestic 3 Feedlot 6 Oil field water supply 9 Dewatering 12 Other (Specify below)

2 Irrigation 4 Industrial 7 Lawn and garden only 10 Observation well

Was a chemical/bacteriological sample submitted to Department? Yes No X; If yes, mo/day/yr sample was submitted

Water Well Disinfected? Yes X No

5 TYPE OF BLANK CASING USED: 5 Wrought iron 8 Concrete tile CASING JOINTS: Glued X Clamped

1 Steel 3 RMP (SR) 6 Asbestos-Cement 9 Other (specify below) Welded

2 PVC 4 ABS 7 Fiberglass Threaded

Blank casing diameter 6 in. to 82 ft., Dia. 82 in. to 102 ft., Dia. 102 in. to 102 ft.

Casing height above land surface 12 in., weight 12.55 lbs./ft. Wall thickness or gauge No. 12.55

TYPE OF SCREEN OR PERFORATION MATERIAL: 7 PVC 10 Asbestos-cement

1 Steel 3 Stainless steel 5 Fiberglass 8 RMP (SR) 11 Other (specify)

2 Brass 4 Galvanized steel 6 Concrete tile 9 ABS 12 None used (open hole)

SCREEN OR PERFORATION OPENINGS ARE: 5 Gauzed wrapped 8 Saw cut 11 None (open hole)

1 Continuous slot 3 Mill slot 6 Wire wrapped 9 Drilled holes

2 Louvered shutter 4 Key punched 7 Torch cut 10 Other (specify)

SCREEN-PERFORATED INTERVALS: From 82 ft. to 102 ft., From 102 ft. to 102 ft.

From 102 ft. to 102 ft., From 102 ft. to 102 ft.

GRAVEL PACK INTERVALS: From 13 ft. to 102 ft., From 102 ft. to 102 ft.

From 102 ft. to 102 ft., From 102 ft. to 102 ft.

6 GROUT MATERIAL: 1 Neat cement 2 Cement grout 3 Bentonite 4 Other

Grout Intervals: From 3 ft. to 13 ft., From 13 ft. to 102 ft., From 102 ft. to 102 ft.

What is the nearest source of possible contamination: 10 Livestock pens 14 Abandoned water well

1 Septic tank 4 Lateral lines 7 Pit privy 11 Fuel storage 15 Oil well/Gas well

2 Sewer lines 5 Cess pool 8 Sewage lagoon 12 Fertilizer storage 16 Other (specify below)

3 Watertight sewer lines 6 Seepage pit 9 Feedyard 13 Insecticide storage

Direction from well? South How many feet? 80

FROM TO LITHOLOGIC LOG FROM TO LITHOLOGIC LOG

0 16 fine sand

16 27 sandy clay

27 55 fine sand

55 61 sandy clay

61 94 fine sand

94 102 sandy clay

7 CONTRACTOR'S OR LANDOWNER'S CERTIFICATION: This water well was 1 constructed, (2) reconstructed, or (3) plugged under my jurisdiction and was completed on (mo/day/year) 6-18-85 and this record is true to the best of my knowledge and belief. Kansas

Water Well Contractor's License No. 193 This Water Well Record was completed on (mo/day/yr) 6-10-86

under the business name of Price Water Well Serv. by (signature) John Paveny

INSTRUCTIONS: Use typewriter or ball point pen, PLEASE PRESS FIRMLY and PRINT clearly. Please fill in blanks, underline or circle the correct answers. Send top three copies to Kansas Department of Health and Environment, Division of Environment, Environmental Geology Section, Topeka, KS 66620. Send one to WATER WELL OWNER and retain one for your records.