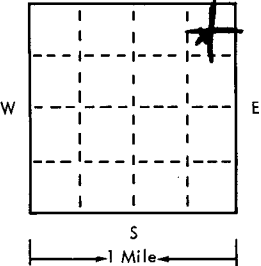
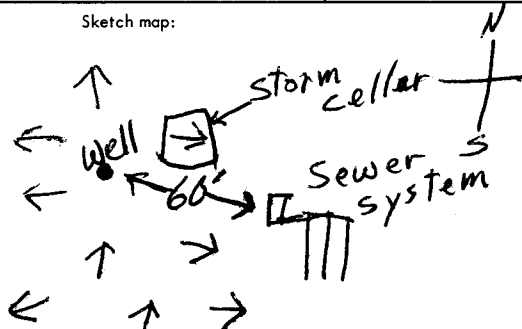


USE TYPEWRITER OR BALL
POINT PEN-PRESS FIRMLY,
PRINT CLEARLY.

WATER WELL RECORD
KSA 82a-1201-1215

T R EW sec 1/4 1/4 No.

Kansas State Dept. Of Health
(Water Well Contractors)
Forbes-Bldg. 740
Topeka, Kansas 66620

1 Location of well:	County <u>Reno</u>	Township name <u>clay</u>	Section number <u>13</u>	Town number <u>23 S</u>	Range number <u>5 W</u>
Distance and direction from nearest town or city: <u>2 mi E of Hutchinson, Ks.</u>			3 Owner of well: <u>Carl Bowser</u>		
Street address of well location if in city:			Address: <u>RT 4 Hutchinson, Ks. 67501</u>		
Locate with "X" in section below:		Sketch map:		4 Well depth: <u>42</u> ft. Date of completion <u>1-23-76</u> Well diameter <u>10</u> in.	
				5 <input type="checkbox"/> Cable tool <input checked="" type="checkbox"/> Rotary <input type="checkbox"/> Driven <input type="checkbox"/> Dug <input type="checkbox"/> Hollow rod <input type="checkbox"/> Jetted <input type="checkbox"/> Bored <input type="checkbox"/> Reverse rotary	
2 Type and color of material		From To		6 Use: <input checked="" type="checkbox"/> Domestic <input type="checkbox"/> Public supply <input type="checkbox"/> Industry <input type="checkbox"/> Irrigation <input type="checkbox"/> Air conditioning <input type="checkbox"/> Commercial <input type="checkbox"/> Test well	
<u>F sand - yellow</u>		<u>0 25</u>		7 Casing: Material <u>RMP</u> Height <u>above</u> below Threaded <input type="checkbox"/> Welded <input type="checkbox"/> Surface <u>14</u> in. Diam. <u>6</u> in. to <u>42</u> ft. depth Drive shoe? <input type="checkbox"/> Yes <input checked="" type="checkbox"/> No	
<u>clay + sand - yellow</u>		<u>25 39</u>		8 Screen: Manufacturer <u>Jess + Howell</u> Type <u>RMP</u> Dia. <u>6"</u> Slot gauge <u>3/32</u> Length <u>20'</u> Set between <u>19</u> ft. and <u>39</u> ft. Fittings: <u>16-1/2</u> Gravel pack <input checked="" type="checkbox"/> Yes <input type="checkbox"/> No Size range of material	
<u>clay - yellow</u>		<u>39 42</u>		9 Static water level: <u>7</u> ft. below land surface Date <u>1-23-76</u>	
				10 Pumping level below land surfaces: <u>38</u> ft. after <u>1/2</u> hrs. pumping <u>18</u> g.p.m. ft. after hrs. pumping g.p.m. Estimated maximum yield <u>18</u> g.p.m.	
				11 Water sample submitted: <input type="checkbox"/> Yes <input checked="" type="checkbox"/> No Date	
				12 Well head completion: <input type="checkbox"/> Pitless adapter <input checked="" type="checkbox"/> Inches above grade	
				13 Well grouted? <input checked="" type="checkbox"/> Yes <input type="checkbox"/> No <input checked="" type="checkbox"/> Neat cement <input type="checkbox"/> Bentonite <input type="checkbox"/> Depth: From <u>0</u> ft. to <u>10</u> ft.	
				14 Nearest source of possible contamination: ft. <u>60</u> Direction <u>SE</u> Type <u>Sewer</u> Well disinfected upon completion? <input checked="" type="checkbox"/> Yes <input type="checkbox"/> No	
				15 Pump: <input checked="" type="checkbox"/> Not installed Manufacturer's name Model number HP Volts Length of drop pipe ft. capacity g.m.p. Type: <input type="checkbox"/> Submersible <input type="checkbox"/> Turbine <input type="checkbox"/> Jet <input type="checkbox"/> Reciprocating <input type="checkbox"/> Centrifugal <input type="checkbox"/> Other	
16 Remarks: elevation				17 Water well contractor's certification: This well was drilled under my jurisdiction and this report is true to the best of my knowledge and belief. <u>Miller Water Well 737</u> Business name <u>Hutchinson, Ks.</u> license No. Address <u>Hutchinson, Ks.</u> Signed <u>Joe Miller</u> Date <u>1-23-76</u> Authorized representative	
Topography: <input type="checkbox"/> Hill <input checked="" type="checkbox"/> Slope <input type="checkbox"/> Upland <input type="checkbox"/> Valley					

Forward the white, blue and pink copies to the Kansas State Dept. Of Health.

Form WWC-5