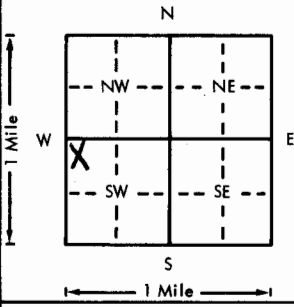
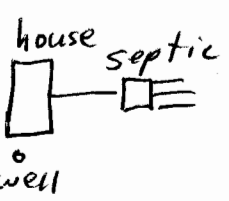


USE TYPEWRITER OR BALL
POINT PEN-PRESS FIRMLY,
PRINT CLEARLY.

WATER WELL RECORD
KSA 82a-1201-1215

Kansas Department of Health and
Environment-Division of Environment
(Water well Contractors)
Topeka, Kansas 66620

1. Location of well:		County Reno	Fraction NW 1/4 NW 1/4 SW 1/4	Section number 14	Township number T 23 S	Range number R 5 E
2. Distance and direction from nearest town or city: Street address of well location if in city:		Hutchinson Kan. 204 Obee Rd.		3. Owner of well: Robert Jones R.R. or street: 204 Obee Rd City, state, zip code: Hutchinson, Kan 67501		
4. Locate with "X" in section below:		Sketch map:		6. Bore hole dia. 9 in. Completion date 2-25-77 Well depth 35 ft.		
				7. Cable tool <input type="checkbox"/> Rotary <input type="checkbox"/> Driven <input type="checkbox"/> Dug <input type="checkbox"/> Hollow rod <input type="checkbox"/> Jetted <input checked="" type="checkbox"/> Bored <input type="checkbox"/> Reverse rotary		
5. Type and color of material		From	To	8. Use: <input checked="" type="checkbox"/> Domestic <input type="checkbox"/> Public supply <input type="checkbox"/> Industry <input type="checkbox"/> Irrigation <input type="checkbox"/> Air conditioning <input type="checkbox"/> Stock <input type="checkbox"/> Lawn <input type="checkbox"/> Oil field water <input type="checkbox"/> Other		
Sandy top soil		0	3	9. Casing: Material Plas Height: Above or below Threaded <input type="checkbox"/> Welded blue Surface 12 in. RMP <input checked="" type="checkbox"/> PVC <input type="checkbox"/> Weight <input type="checkbox"/> lbs./ft. Dia. 6 in. to 35 ft. depth Wall Thickness: inches or Dia. <input type="checkbox"/> in. to <input type="checkbox"/> ft. depth gage No. 175		
Sandy clay		3	7	10. Screen: Manufacturer's name J & L Type RMP Dia. 6" Slot/gauze 1/8 hole Length 10' Set between 25 ft. and 35 ft. ft. and ft. Gravel pack? NO Size range of material		
grey clay		7	11	11. Static water level: <input type="checkbox"/> mo./day/yr. 19 ft. below land surface Date 2-25-77		
fine sand		11	14	12. Pumping level below land surfaces: 19 1/2 ft. after 2 hrs. pumping 15 g.p.m. ft. after hrs. pumping g.p.m. Estimated maximum yield 50 g.p.m.		
medium gravel		14	35	13. Water sample submitted: <input type="checkbox"/> mo./day/yr. Yes <input checked="" type="checkbox"/> No Date		
				14. Well head completion: <input checked="" type="checkbox"/> Pitless adapter 12 inches above grade		
				15. Well grouted? yes With: <input checked="" type="checkbox"/> Neat cement <input type="checkbox"/> Bentonite <input type="checkbox"/> Concrete Depth: From 3 ft. to 13 ft.		
				16. Nearest source of possible contamination: ft. 65 Direction N E Type Septic Well disinfected upon completion? <input checked="" type="checkbox"/> Yes <input type="checkbox"/> No		
				17. Pump: <input type="checkbox"/> Not installed Manufacturer's name Valley Model number S1208 HP 1/2 Volts 230 Length of drop pipe 22 ft. capacity 20 g.p.m. Type: <input checked="" type="checkbox"/> Submersible <input type="checkbox"/> Turbine <input type="checkbox"/> Jet <input type="checkbox"/> Reciprocating <input type="checkbox"/> Centrifugal <input type="checkbox"/> Other		
		(Use a second sheet if needed)		20. Water well contractor's certification: This well was drilled under my jurisdiction and this report is true to the best of my knowledge and belief. Price Water Well 193 Business name License No. Address RR 3 Hutchinson Signed John Davenport Date 5-12-77 Authorized representative		
18. Elevation:		19. Remarks:				
Topography: <input type="checkbox"/> Hill <input type="checkbox"/> Slope <input type="checkbox"/> Upland <input checked="" type="checkbox"/> Valley						

Forward the white, blue and pink copies to the Department of Health and Environment

Form WWC-5