


1 LOCATION OF WATER WELL:	Fraction	Section Number	Township Number	Range Number
County: <i>Reno</i>	<i>NE</i> $\frac{1}{4}$ <i>SE</i> $\frac{1}{4}$ <i>SW</i> $\frac{1}{4}$	<i>15</i>	T <i>23</i> S	R <i>5</i> E <i>(W)</i>

Distance and direction from nearest town or city street address of well if located within city?  
 N = 1314922.460 E = 497271.866 SE cor Sec 10: N = 1819433.10 E = 499892.51

2	WATER WELL OWNER:	Cessna Aircraft	MW-250
	RR#, St. Address, Box # :	P.O. Box 7704	Board of Agriculture, Division of Water Resources
	City, State, ZIP Code :	Wichita KS 67277	Application Number:

3 LOCATE WELL'S LOCATION WITH AN "X" IN SECTION BOX: 4 DEPTH OF COMPLETED WELL: 60 ft. ELEVATION: TOC=1517.67 GL=1514.15

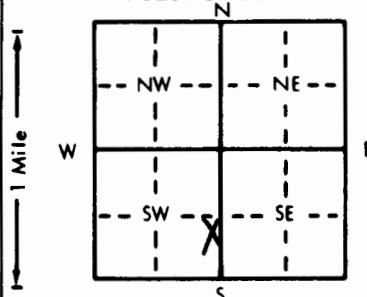

4 DEPTH OF COMPLETED WELL ..... 60 ..... ft. ELEVATION: TDC = 1517.67 GL = 1514.75  
Depth(s) Groundwater Encountered 1. .... 15.5 ..... ft. 2. .... ft. 3. .... ft.  
WELL'S STATIC WATER LEVEL .... 15.5 ..... ft. below land surface measured on mo/day/yr 3-30-92  
Pump test data: Well water was ..... ft. after ..... hours pumping ..... gpm  
Est. Yield ..... gpm Well water was ..... ft. after ..... hours pumping ..... gpm  
Bore Hole Diameter ..... 7.25 ..... in. to ..... 6.2 ..... ft., and ..... in. to ..... ft.  
WELL WATER TO BE USED AS: 5 Public water supply 8 Air conditioning 11 Injection well  
1 Domestic 3 Feedlot 6 Oil field water supply 9 Dewatering 12 Other (Specify below)  
2 Irrigation 4 Industrial 7 Lawn and garden only 10 Monitoring well  
Was a chemical/bacteriological sample submitted to Department? Yes ..... No ..... X If yes, mo/day/yr sample was sub-  
mitted Water Well Disinfected? Yes No X

5 TYPE OF BLANK CASING USED: 5 Wrought iron 8 Concrete tile CASING JOINTS: Glued . . . . . Clamped . . . . .  
1 Steel 3 RMP (SR) 6 Asbestos-Cement 9 Other (specify below) Welded . . . . .  
2 PVC 4 ABS 7 Fiberglass . . . . . Threaded. X  
Blank casing diameter 2 in. to 50 ft. Dia . . . . . in. to . . . . . ft. Dia . . . . . in. to . . . . . ft.  
Casing height above land surface 30 in. weight . . . . . lbs./ft. Wall thickness or gauge No. 5640

TYPE OF SCREEN OR PERFORATION MATERIAL:				
1 Steel	3 Stainless steel	5 Fiberglass	7 <u>PVC</u>	10 Asbestos-cement
2 Brass	4 Galvanized steel	6 Concrete tile	8 RMP (SR)	11 Other (specify) .....
			9 ABS	12 None used (open hole)

SCREEN OR PERFORATION OPENINGS ARE:

1 Continuous slot	5 Gauzed wrapped	8 Saw cut	11 None (open hole)
2 Louvered shutter	6 Wire wrapped	9 Drilled holes	
3 Mill slot	7 Torch cut	10 Other (specify) .....	
4 Key punched			

SCREEN-PERFORATED INTERVALS:	From	50	ft. to	60	ft., From	ft. to	ft.
	From		ft. to		ft., From	ft. to	ft.
GRAVEL PACK INTERVALS:	From	45	ft. to	60	ft., From	ft. to	ft.
	From		ft. to		ft., From	ft. to	ft.

6 GROUT MATERIAL: 1 Neat cement 2 Cement grout 3 Bentonite 4 Other \_\_\_\_\_  
Grout Intervals: From Surface ft. to 45 ft., From \_\_\_\_\_ ft. to \_\_\_\_\_ ft., From \_\_\_\_\_ ft. to \_\_\_\_\_ ft.

What is the nearest source of possible contamination:

1 Septic tank	4 Lateral lines	7 Pit privy	10 Livestock pens	14 Abandoned water well
2 Sewer lines	5 Cess pool	8 Sewage lagoon	11 Fuel storage	15 Oil well/Gas well
3 Watertight sewer lines	6 Seepage pit	9 Feedyard	12 Fertilizer storage	16 Other (specify below)
Direction from well?	N 30° W		13 Insecticide storage	Industrial site
			How many feet?	~ 4000

[illegible]

7 CONTRACTOR'S OR LANDOWNER'S CERTIFICATION: This water well was (1) constructed, (2) reconstructed, or (3) plugged under my jurisdiction and was completed on (mo/day/year) 3-16-92 and this record is true to the best of my knowledge and belief. Kansas Water Well Contractor's License No. 517 This Water Well Record was completed on (mo/day/year) 4-1-92 under the business name of Groundwater Technology, Inc by (signature) Steve Threlkoff