


1 LOCATION OF WATER WELL:		Fraction	Section Number	Township Number	Range Number
County: RENO		CSL 1/4 SE 1/4 SE 1/4	15	T 23 S	R 5 NW
Distance and direction from nearest town or city street address of well if located within city? South of RR tracks					
MW-30I					
2 WATER WELL OWNER: Eaton Corp					
RR#, St. Address, Box #: 3401 E 4th					
City, State, ZIP Code: Hutchinson, KS 67501					
Board of Agriculture, Division of Water Resources Application Number:					
3 LOCATE WELL'S LOCATION WITH AN "X" IN SECTION BOX:		4 DEPTH OF COMPLETED WELL: 44.1 ft. ELEVATION: 1511.41			
		Depth(s) Groundwater Encountered 15 ft. 2. ft. 3. ft.			
		WELL'S STATIC WATER LEVEL 15 ft. below land surface measured on mo/day/yr			
		Pump test data: Well water was ft. after hours pumping gpm			
		Est. Yield gpm: Well water was ft. after hours pumping gpm			
		Bore Hole Diameter 8 in. to 44.1 ft., and in. to ft.			
WELL WATER TO BE USED AS:					
1 Domestic 3 Feedlot 6 Oil field water supply 9 Dewatering 12 Other (Specify below) 2 Irrigation 4 Industrial 7 Lawn and garden only 10 Monitoring well					
Was a chemical/bacteriological sample submitted to Department? Yes No X ; If yes, mo/day/yr sample was submitted					
Water Well Disinfected? Yes No X					
5 TYPE OF BLANK CASING USED:					
1 Steel 3 RMP (SR) 5 Wrought iron 8 Concrete tile CASING JOINTS: Glued Clamped 2 PVC 4 ABS 6 Asbestos-Cement 9 Other (specify below) Welded 7 Fiberglass Threaded X					
Blank casing diameter 2 in. to 34.1 ft., Dia. in. to ft., Dia. in. to ft.					
Casing height above land surface 24 in., weight 69 lbs./ft. Wall thickness or gauge No. 154					
TYPE OF SCREEN OR PERFORATION MATERIAL:					
1 Steel 3 Stainless steel 5 Fiberglass 8 RMP (SR) 10 Asbestos-cement 2 Brass 4 Galvanized steel 6 Concrete tile 9 ABS 11 Other (specify) 12 None used (open hole)					
SCREEN OR PERFORATION OPENINGS ARE:					
1 Continuous slot 3 Mill slot 5 Gauzed wrapped 8 Saw cut 11 None (open hole) 2 Louvered shutter 4 Key punched 6 Wire wrapped 9 Drilled holes 7 Torch cut 10 Other (specify)					
SCREEN-PERFORATED INTERVALS: From 34.1 ft. to 44.1 ft., From ft. to ft.					
GRAVEL PACK INTERVALS: From 32 ft. to 44.1 ft., From ft. to ft.					
6 GROUT MATERIAL: 1 Neat cement 2 Cement grout 3 Bentonite 4 Other					
Grout Intervals: From 0 ft. to 1 ft., From 1 ft. to 32 ft., From ft. to ft.					
What is the nearest source of possible contamination:					
1 Septic tank 4 Lateral lines 7 Pit privy 10 Livestock pens 14 Abandoned water well 2 Sewer lines 5 Cess pool 8 Sewage lagoon 11 Fuel storage 15 Oil well/Gas well 3 Watertight sewer lines 6 Seepage pit 9 Feedyard 12 Fertilizer storage 16 Other (specify below) farm field					
Direction from well? NA How many feet? NA					
FROM		TO		LITHOLOGIC LOG	
FROM		TO		PLUGGING INTERVALS	
0		10		Clay & Silt	
10		44		Sand - fine to coarse	
7 CONTRACTOR'S OR LANDOWNER'S CERTIFICATION: This water well was (1) constructed, (2) reconstructed, or (3) plugged under my jurisdiction and was completed on (mo/day/year) 6/14/93 and this record is true to the best of my knowledge and belief. Kansas					
Water Well Contractor's License No. 102 W This Water Well Record was completed on (mo/day/yr) 6/29/93					
under the business name of Layne, Inc. by (signature) Steven R. Mitchell					
INSTRUCTIONS: Use typewriter or ball point pen. PLEASE PRESS FIRMLY and PRINT clearly. Please fill in blanks, underline or circle the correct answers. Send top three copies to Kansas Department of Health and Environment, Bureau of Water, Topeka, Kansas 66620-0001. Telephone: 913-296-5545. Send one to WATER WELL OWNER and retain one for your records.					

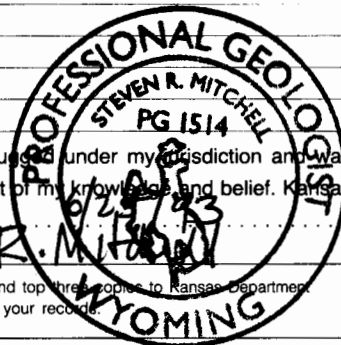

OFFICE USE ONLY

T

R

EW

SEC.

1

1/4

1/4