


1 LOCATION OF WATER WELL: Fraction SW 1/4 NW 1/4 NW 1/4 Section Number 16 Township Number T 23 S Range Number R 5 E (W)  
 County: Rego

Distance and direction from nearest town or city street address of well if located within city?

Same Street Address

2 WATER WELL OWNER: Concrete Int  
 RR#, St. Address, Box #: 2430 E 1st  
 City, State, ZIP Code: Hutchinson Kan. 67501  
 Board of Agriculture, Division of Water Resources  
 Application Number:

3 LOCATE WELL'S LOCATION WITH AN "X" IN SECTION BOX:

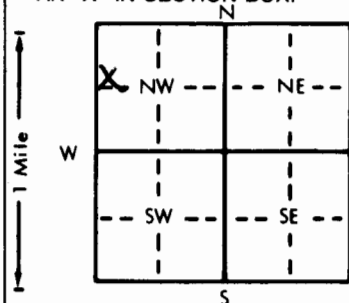

4 DEPTH OF COMPLETED WELL 40 ft. ELEVATION: 10-18-84

Depth(s) Groundwater Encountered 1. 19 ft. 2. 19 ft. 3. 19 ft.

WELL'S STATIC WATER LEVEL 19 ft. below land surface measured on mo/day/yr 10-18-84

Pump test data: Well water was X ft. after X hours pumping X gpm

Est. Yield X gpm: Well water was X ft. after X hours pumping X gpm

Bore Hole Diameter 8 in. to 40 ft., and 40 in. to 40 ft.

WELL WATER TO BE USED AS: 5 Public water supply 8 Air conditioning 11 Injection well

1 Domestic 3 Feedlot 6 Oil field water supply 9 Dewatering 12 Other (Specify below)

2 Irrigation 4 Industrial 7 Lawn and garden only 10 Observation well

Was a chemical/bacteriological sample submitted to Department? Yes X No X; If yes, mo/day/yr sample was submitted

Water Well Disinfected? Yes X No X

5 TYPE OF BLANK CASING USED: 5 Wrought iron 8 Concrete tile CASING JOINTS: Glued X Clamped X

1 Steel 3 RMP (SR) 6 Asbestos-Cement 9 Other (specify below) Welded X

2 PVC 4 ABS 7 Fiberglass Threaded X

Blank casing diameter 5 in. to 40 ft., Dia 40 in. to 40 ft., Dia 40 in. to 40 ft.

Casing height above land surface 19 in., weight 160 lbs./ft. Wall thickness or gauge No. 160

TYPE OF SCREEN OR PERFORATION MATERIAL: 7 PVC 10 Asbestos-cement

1 Steel 3 Stainless steel 5 Fiberglass 8 RMP (SR) 11 Other (specify)

2 Brass 4 Galvanized steel 6 Concrete tile 9 ABS 12 None used (open hole)

SCREEN OR PERFORATION OPENINGS ARE: 5 Gauzed wrapped 8 Saw cut 11 None (open hole)

1 Continuous slot 3 Mill slot 6 Wire wrapped 9 Drilled holes

2 Louvered shutter 4 Key punched 7 Torch cut 10 Other (specify)

SCREEN-PERFORATED INTERVALS: From 30 ft. to 40 ft., From 30 ft. to 40 ft., From 30 ft. to 40 ft.

GRAVEL PACK INTERVALS: From 30 ft. to 40 ft., From 30 ft. to 40 ft., From 30 ft. to 40 ft.




6 GROUT MATERIAL: Neat cement Cement grout 3 Bentonite 4 Other

Grout Intervals: From 0 ft. to 10 ft., From 0 ft. to 10 ft., From 0 ft. to 10 ft.

What is the nearest source of possible contamination: 10 Livestock pens 14 Abandoned water well

1 Septic tank 4 Lateral lines 7 Pit privy 11 Fuel storage 15 Oil well/Gas well

2 Sewer lines 5 Cess pool 8 Sewage lagoon 12 Fertilizer storage 16 Other (specify below)

3 Watertight sewer lines 6 Seepage pit 9 Feedyard 13 Insecticide storage

Direction from well? South How many feet? 300

FROM TO LITHOLOGIC LOG FROM TO LITHOLOGIC LOG

0 15 top Soil 0 15 top Soil

15 20 Sand 15 20 Sand

20 27 Clay 20 27 Clay

27 40 Gravel 27 40 Gravel



7 CONTRACTOR'S OR LANDOWNER'S CERTIFICATION: This water well was (1) constructed, (2) reconstructed, or (3) plugged under my jurisdiction and was completed on (mo/day/year) 10-18-84 and this record is true to the best of my knowledge and belief. Kansas

Water Well Contractor's License No. 4480 This Water Well Record was completed on (mo/day/yr) 6-23-85

under the business name of Carl Vincent Service by (signature) Carl Vincent

INSTRUCTIONS: Use typewriter or ball point pen, PLEASE PRESS FIRMLY and PRINT clearly. Please fill in blanks, underline or circle the correct answers. Send top three copies to Kansas Department of Health and Environment, Division of Environment, Environmental Geology Section, Topeka, KS 66620. Send one to WATER WELL OWNER and retain one for your records.