

1 LOCATION OF WATER WELL:	Fraction	Section Number	Township Number	Range Number
County: RENO	C-E/2 1/4 SE 1/4 NE 1/4	16	T 23 S	R 5 NW

Distance and direction from nearest town or city street address of well if located within city?

SE of plant**RW-2**

2 WATER WELL OWNER:	Board of Agriculture, Division of Water Resources
RR#, St. Address, Box # : 3401 E 4th	Application Number:
City, State, ZIP Code : Hutchinson, KS 67501	

3 LOCATE WELL'S LOCATION WITH AN "X" IN SECTION BOX:	4 DEPTH OF COMPLETED WELL: 63.8 ft. ELEVATION: 1519.58
	Depth(s) Groundwater Encountered 1. 15 ft. 2. . ft. 3. . ft.
	WELL'S STATIC WATER LEVEL . ft. below land surface measured on mo/day/yr
	Pump test data: Well water was . ft. after . hours pumping . gpm
	Est. Yield 350 gpm: Well water was . ft. after . hours pumping . gpm
Bore Hole Diameter: 20 in. to 64 in. to . ft. and . in. to . ft.	
WELL WATER TO BE USED AS:	5 Public water supply 8 Air conditioning 11 Injection well
1 Domestic 3 Feedlot 6 Oil field water supply 9 Dewatering 12 Other (Specify below)	
2 Irrigation 4 Industrial 7 Lawn and garden only 10 Monitoring well	RECOVERY WELL
Was a chemical/bacteriological sample submitted to Department? Yes . No X ; If yes, mo/day/yr sample was submitted	Water Well Disinfected? Yes . No X


5 TYPE OF BLANK CASING USED:	5 Wrought iron 8 Concrete tile CASING JOINTS: Glued . Clamped .
1 Steel SS 3 RMP (SR)	6 Asbestos-Cement 9 Other (specify below) Welded .
2 PVC 4 ABS	7 Fiberglass Threaded . X
Blank casing diameter . 10.75 in. to 15 ft. Dia . in. to . ft. Dia . in. to . ft.	
Casing height above land surface . 26 in. weight 28 lbs./ft. Wall thickness or gauge No. 200	
TYPE OF SCREEN OR PERFORATION MATERIAL:	7 PVC 10 Asbestos-cement
1 Steel 3 Stainless steel 5 Fiberglass 8 RMP (SR) 11 Other (specify)	
2 Brass 4 Galvanized steel 6 Concrete tile 9 ABS 12 None used (open hole)	
SCREEN OR PERFORATION OPENINGS ARE:	5 Gauzed wrapped 8 Saw cut 11 None (open hole)
1 Continuous slot 3 Mill slot 6 Wire wrapped 9 Drilled holes	
2 Louvered shutter 4 Key punched 7 Torch cut 10 Other (specify)	
SCREEN-PERFORATED INTERVALS: From . 18.8 ft. to . 63.8 ft. From . ft. to . ft.	
GRAVEL PACK INTERVALS: From . 11.5 ft. to . 63.8 ft. From . ft. to . ft.	

6 GROUT MATERIAL:	1 Neat cement 2 Cement grout 3 Bentonite 4 Other pittless adpt.
Grout Intervals: From . ft. to . ft. From . 5 ft. to . 11.5 ft. From . ft. to . ft.	
What is the nearest source of possible contamination:	10 Livestock pens 14 Abandoned water well
1 Septic tank 4 Lateral lines 7 Pit privy 11 Fuel storage 15 Oil well/Gas well	
2 Sewer lines 5 Cess pool 8 Sewage lagoon 12 Fertilizer storage 16 Other (specify below)	
3 Watertight sewer lines 6 Seepage pit 9 Feedyard 13 Insecticide storage sand pit	
Direction from well? SE	How many feet? 200

FROM	TO	LITHOLOGIC LOG	FROM	TO	PLUGGING INTERVALS
0	5	Clay - tr. sand			
5	15	Silt			
15	20	Silt - clayey 1/8" sand/gravel			
20		Sand - crs - fine			
35	35	trace clay between 25-30			
50	50	Sand & gravel - med			
55	55	Sand - afa & silt			
64	64	Sand - fine to crs			
64	69	Shale - brown & green			

7 CONTRACTOR'S OR LANDOWNER'S CERTIFICATION: This water well was (1) constructed, (2) reconstructed, or (3) plugged under my jurisdiction and was completed on (mo/day/year) 6/14/93 and this record is true to the best of my knowledge and belief. Kansas
Water Well Contractor's License No. 102W This Water Well Record was completed on (mo/day/yr) 6/14/93
under the business name of Layne, Inc. by (signature) Steven R. Mitchell

INSTRUCTIONS: Use typewriter or ball point pen. PLEASE PRESS FIRMLY and PRINT clearly. Please fill in blanks, underline or circle the correct answers. Send trip three copies to Kansas Department of Health and Environment, Bureau of Water, Topeka, Kansas 66620-0001. Telephone: 913-296-5545. Send one to WATER WELL OWNER and retain one for your records.

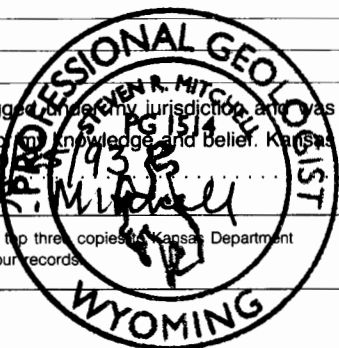

OFFICE USE ONLY

T

R

EW

SEC.

1/4

1/4