WATER WELL RECORD Form WWC-5 KSA 82a-1212

1 LOCATION OF WATER WELL: County: RENO	Fraction: SW ¼ SW ¼ SW ¼	Section Number: 16	Township Number: T 23 S	Range Number: R 5 E (W)

Distance and direction from nearest town or city street address of well if located within city?
400 S. HALSTEAD, HUTCHINSON, KS MW-3

2 WATER WELL OWNER: KANSAS DEPT. OF CORRECTIONS
RR#, St. Address, Box # : 900 SW JACKSON - SUITE 400N
City, State, ZIP Code : TOPEKA, KS 66612

Board of Agriculture, Division of Water Resources
Application Number:

3 LOCATE WELL'S LOCATION WITH AN "X" IN SECTION BOX:

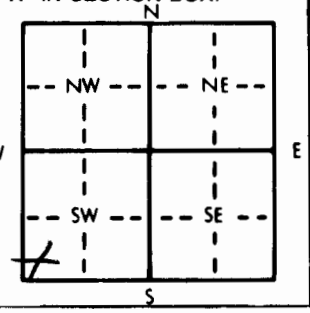

4 DEPTH OF COMPLETED WELL: 22.3 ft. ELEVATION: 1519.49
Depth(s) Groundwater Encountered 1. 12 ft. 2. — ft. 3. — ft.
WELL'S STATIC WATER LEVEL 11.83 ft. below land surface measured on mo/day/yr 5-18-93
Pump test data: Well water was — ft. after — hours pumping — gpm
Est. Yield — gpm: Well water was — ft. after — hours pumping — gpm
Bore Hole Diameter 8 in. to 25.5 ft., and — in. to — ft.
WELL WATER TO BE USED AS: 5 Public water supply 8 Air conditioning 11 Injection well
1 Domestic 3 Feedlot 6 Oil field water supply 9 Dewatering 12 Other (Specify below)
2 Irrigation 4 Industrial 7 Lawn and garden only (10) Monitoring well
Was a chemical/bacteriological sample submitted to Department? Yes ..... No X ; If yes, mo/day/yr sample was submitted
Water Well Disinfected? Yes (No)

5 TYPE OF BLANK CASING USED: 5 Wrought iron 8 Concrete tile CASING JOINTS: Glued ..... Clamped .....
1 Steel 3 RMP (SR) 6 Asbestos-Cement 9 Other (specify below) Welded .....
(2) PVC 4 ABS 7 Fiberglass Threaded X
Blank casing diameter 2 in. to 12.3 ft., Dia — in. to — ft., Dia — in. to — ft.
Casing height above land surface — 2.9 in., weight — lbs./ft. Wall thickness or gauge No. 40
TYPE OF SCREEN OR PERFORATION MATERIAL: (7) PVC 10 Asbestos-cement
1 Steel 3 Stainless steel 5 Fiberglass 8 RMP (SR) 11 Other (specify)
2 Brass 4 Galvanized steel 6 Concrete tile 9 ABS 12 None used (open hole)
SCREEN OR PERFORATION OPENINGS ARE: 5 Gauzed wrapped 8 Saw cut 11 None (open hole)
1 Continuous slot (3) Mill slot 6 Wire wrapped 9 Drilled holes
2 Louvered shutter 4 Key punched 7 Torch cut 10 Other (specify)
SCREEN-PERFORATED INTERVALS: From 22.3 ft. to 12.3 ft., From — ft. to — ft.
From — ft. to — ft., From — ft. to — ft.
GRAVEL PACK INTERVALS: From 25.5 ft. to 10.5 ft., From — ft. to — ft.
From — ft. to — ft., From — ft. to — ft.

6 GROUT MATERIAL: (1) Neat cement 2 Cement grout (3) Bentonite 4 Other
Grout Intervals: From 10.5 ft. to 0 ft., From — ft. to — ft., From — ft. to — ft.
What is the nearest source of possible contamination: 10 Livestock pens 14 Abandoned water well
1 Septic tank 4 Lateral lines 7 Pit privy (11) Fuel storage 15 Oil well/Gas well
2 Sewer lines 5 Cess pool 8 Sewage lagoon 12 Fertilizer storage 16 Other (specify below)
3 Watertight sewer lines 6 Seepage pit 9 Feedyard 13 Insecticide storage
Direction from well? NORTHWEST How many feet? 160

FROM	TO	LITHOLOGIC LOG	FROM	TO	PLUGGING INTERVALS
0	0.5	CONCRETE			
0.5	8.5	Grey Brown Silty Clay			
8.5	12.0	Grey Brown Sandy Silty Clay			
12.0	16.5	Grey Brown Fine Grain SAND			
16.5	23.0	Lt. Brown Coarse Grain Sand w/Some Gravel			
23.0	25.5	Lt. Brown Coarse Grain Sand w/Some Gravel			

7 CONTRACTOR'S OR LANDOWNER'S CERTIFICATION: This water well was (1) constructed, (2) reconstructed, or (3) plugged under my jurisdiction and was completed on (mo/day/year) 5/14 and this record is true to the best of my knowledge and belief. Kansas Water Well Contractor's License No. 216 This Water Well Record was completed on (mo/day/yr) 7/23/93
under the business name of Terracon Consultants Inc by (signature) Richard D. Murphy

INSTRUCTIONS: Use typewriter or ball point pen. *PLEASE PRESS FIRMLY* and *PRINT* clearly. Please fill in blanks, underline or circle the correct answers. Send top three copies to Kansas Department of Health and Environment, Bureau of Water, Topeka, Kansas 66620-0001. Telephone: 913-296-5545. Send one to WATER WELL OWNER and retain one for your records.

OFFICE USE ONLY T R E/W SEC. ¼ ¼ ¼