

1 LOCATION OF WATER WELL: County: <u>Reynolds</u>	Fraction <u>NW</u> $\frac{1}{4}$ <u>NW</u> $\frac{1}{4}$ <u>SE</u> $\frac{1}{4}$	Section Number <u>17</u>	Township Number T <u>23</u> S	Range Number R <u>5</u> <u>EW</u>
--	---	-----------------------------	----------------------------------	--------------------------------------

Distance and direction from nearest town or city street address of well if located within city?
45+ mi Airport Rd 150 West $\frac{1}{2}$ North $\frac{1}{2}$ West North Side


2 WATER WELL OWNER: North American Salt

RR#, St. Address, Box # : Carey Blvd
City, State, ZIP Code : Hutchinson KS

3 LOCATE WELL'S LOCATION WITH AN "X" IN SECTION BOX: 4 DEPTH OF COMPLETED WELL... 50 ft. ELEVATION: 15

AN "X" IN SECTION BOX:
N

4 DEPTH OF COMPLETED WELL 50 ft. ELEVATION: 15

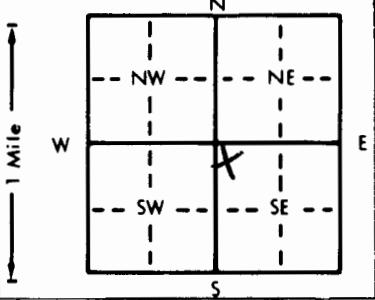

Depth(s) Groundwater Encountered 1. 15 ft. 2. _____ ft. 3. 20-21 ft.

WELL'S STATIC WATER LEVEL 15 ft. below land surface measured on mo/day/yr 2-20-91

Pump test data: Well water was NA ft. after hours pumping gpm

Est. Yield gpm: Well water was ft. after hours pumping gpm

Bore Hole Diameter . . . 8 . . . in. to . . . 50 . . . ft., and . . . in. to . . . ft.

WELL WATER TO BE USED AS: 5 Public water supply 8 Air conditioning 11 Injection well

1 Domestic	3 Feedlot	6 Oil field water supply	9 Dewatering	12 Other (Specify below)
------------	-----------	--------------------------	--------------	--------------------------

2 Irrigation 4 Industrial 7 Lawn and garden only 10 Monitoring well

Was a chemical/bacteriological sample submitted to Department? Yes..... No X.....; If yes, mo/day/yr sample was sub

5 TYPE OF BLANK CASING USED:

5 Wrought iron	8 Concrete tile	CASING JOINTS: Glued Clamped
----------------	-----------------	--

1 Steel 3 RMP (SR) 6 Asbestos-Cement 9 Other (specify below) Welded

2 PVC 4 ABS 45 7 Fiberglass Threaded. X

Blank casing diameter 4 in. to 4.5 ft., Dia 6.5 in. to 8.0 ft., Dia 8.0 in. to 8.5 ft.

Casing height above land surface... 24 ... in., weight Sec 80 ... lbs./ft. Wall thickness or gauge No.

TYPE OF SCREEN OR PERFORATION MATERIAL: 7 PVC 10 Asbestos-cement

1 Steel 3 Stainless steel 5 Fiberglass 8 RMP (SR) 11 Other (specify)

2 Brass	4 Galvanized steel	6 Concrete tile	9 ABS	12 None used (open hole)
---------	--------------------	-----------------	-------	--------------------------

SCREEN OR PERFORATION OPENINGS ARE: 5 Gauzed wrapped 8 Saw cut 11 None (open hole)

1 Continuous slot	3 Mill slot	6 Wire wrapped	9 Drilled holes
-------------------	-------------	----------------	-----------------

2 Louvered shutter 4 Key punched 7 Torch cut 10 Other (specify)

SCREEN-PERFORATED INTERVALS: From 45 ft. to 50 ft., From _____ ft. to _____ ft.


GRAVEL PACK INTERVALS: From 43 ft. to 50 ft. From _____ ft. to _____ ft.

From		ft. to		ft. From		ft. to	
From	ft. to	ft. From	ft. to	ft. From	ft. to	ft. From	ft. to

6	GROUT MATERIAL:	1 Neat cement	2 Cement grout	3 Bentonite	4 Other
---	-----------------	---------------	----------------	-------------	---------

Grout Intervals: From 0 ft. to 41 ft. From 41 ft. to 43 ft. From _____ ft. to _____ ft.

What is the nearest source of possible contamination: 10 Livestock pens 14 Abandoned water well


1 Septic tank	4 Lateral lines	7 Pit privy	11 Fuel storage	15 Oil well/Gas well
2 Sewer lines	5 Cess pool	8 Sewage lagoon	12 Fertilizer storage	16 Other (specify below)

3 Watertight sewer lines	6 Seepage pit	9 Feedyard	13 Insecticide storage	Brinsfield

3 Watertight sewer lines 6 Seepage pit 9 Feedyard 13 Insecticide storage 01/11/19
Direction from well? South How many feet? 50

Direction from well? <u>SOUTH</u>		How many feet? <u>50</u>	
FROM	TO	LITHOLOGIC LOG	PLUGGING INTERVALS

[illegible]

7 CONTRACTOR'S OR LANDOWNER'S CERTIFICATION: This water well was (1) constructed, (2) reconstructed, or (3) plugged under my jurisdiction and was

completed on (mo/day/year) 05-25-1991 and this record is true to the best of my knowledge and belief. Kansas

Water Well Contractor's License No. 537 This Water Well Record was completed on (mo/day/yr) 3-10-90

under the business name of Flowers Drilling & Pump Serv. by (signature) Mike Flowers