
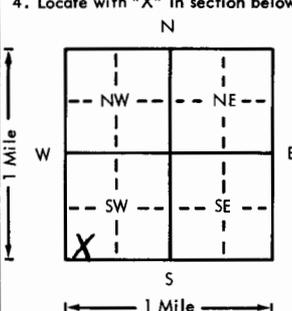
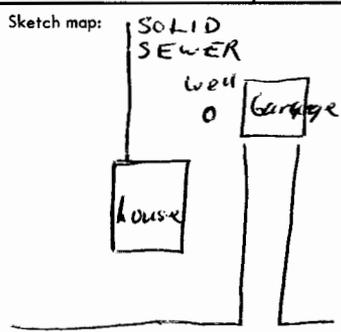


USE TYPEWRITER OR BALL POINT PEN-PRESS FIRMLY, PRINT CLEARLY.

WATER WELL RECORD
KSA 82a-1201-1215

Kansas Department of Health and Environment-Division of Environment
(Water well Contractors)
Topeka, Kansas 66620

<input checked="" type="checkbox"/> 1. Location of well:	County <u>Reno</u>	Fraction <u>SW 1/4 SW 1/4 SW 1/4</u>	Section number <u>18</u>	Township number <u>T 23 S R 5 E W</u>	Range number
2. Distance and direction from nearest town or city: Street address of well location if in city:	<u>530 E Campbell Hutchinson</u>		3. Owner of well: <u>Leonard Mings</u> R.R. or street: <u>530 E. Campbell</u> City, state, zip code: <u>Hutchinson Kan. 67501</u>		
4. Locate with "X" in section below:	Sketch map:		6. Bore hole dia. <u>9</u> in. Completion date <u>5-14-75</u> Well depth <u>36</u> ft.		
			7. <input type="checkbox"/> Cable tool <input type="checkbox"/> Rotary <input type="checkbox"/> Driven <input checked="" type="checkbox"/> Dug <input type="checkbox"/> Hollow rod <input type="checkbox"/> Jetted <input checked="" type="checkbox"/> Bored <input type="checkbox"/> Reverse rotary		
5. Type and color of material	From	To	8. Use: <input type="checkbox"/> Domestic <input type="checkbox"/> Public supply <input type="checkbox"/> Industry <input type="checkbox"/> Irrigation <input type="checkbox"/> Air conditioning <input type="checkbox"/> Stock <input checked="" type="checkbox"/> Lawn <input type="checkbox"/> Oil field water <input type="checkbox"/> Other		
<u>Sandy top soil</u>	<u>0</u>	<u>3</u>	9. Casing: Material <u>Plus</u> Height: <u>Above</u> or below Threaded <input type="checkbox"/> Welded <u>Glue</u> Surface <u>12</u> in. RMP <input checked="" type="checkbox"/> PVC <input type="checkbox"/> Weight <u> </u> lbs./ft. Dia. <u>6</u> in. to <u>36</u> ft. depth Wall Thickness: inches or Dia. <u> </u> in. to <u> </u> ft. depth gage No. <u>175</u>		
<u>brown sandy clay</u>	<u>3</u>	<u>11</u>	10. Screen: Manufacturer's name <u>JEL</u> Type <u>RMP</u> Dia. <u>6"</u> Slot/gauze <u>1/8 hole</u> Length <u>10'</u> Set between <u>26</u> ft. and <u>36</u> ft. <u> </u> ft. and <u> </u> ft.		
<u>fine gravel</u>	<u>11</u>	<u>14</u>	Gravel pack? <u>No</u> Size range of material <u> </u>		
<u>medium gravel</u>	<u>14</u>	<u>36</u>	11. Static water level: <u> </u> mo./day/yr. <u>18</u> ft. below land surface Date <u>5-16-75</u>		
			12. Pumping level below land surfaces: <u>18 1/2</u> ft. after <u>1</u> hrs. pumping <u>20</u> g.p.m. <u> </u> ft. after <u> </u> hrs. pumping <u> </u> g.p.m. Estimated maximum yield <u>50</u> g.p.m.		
			13. Water sample submitted: <u> </u> mo./day/yr. <input type="checkbox"/> Yes <input checked="" type="checkbox"/> No Date <u> </u>		
			14. Well head completion: <u> </u> <input type="checkbox"/> Pitless adapter <u>12</u> Inches above grade		
			15. Well grouted? <u>yes</u> With: <input checked="" type="checkbox"/> Neat cement <input type="checkbox"/> Bentonite <input type="checkbox"/> Concrete Depth: From <u>3</u> ft. to <u>13</u> ft.		
			16. Nearest source of possible contamination: <u>Solid</u> ft. <u>30</u> Direction <u>W</u> Type <u>Sewer</u> Well disinfected upon completion? <input type="checkbox"/> Yes <input checked="" type="checkbox"/> No		
			17. Pump: <input checked="" type="checkbox"/> Not installed Manufacturer's name <u> </u> Model number <u> </u> HP <u> </u> Volts <u> </u> Length of drop pipe <u> </u> ft. capacity <u> </u> g.p.m. Type: <input type="checkbox"/> Submersible <input type="checkbox"/> Turbine <input type="checkbox"/> Jet <input type="checkbox"/> Reciprocating <input type="checkbox"/> Centrifugal <input type="checkbox"/> Other		
18. Elevation:	19. Remarks:		20. Water well contractor's certification: This well was drilled under my jurisdiction and this report is true to the best of my knowledge and belief. <u>Price Water Well 193</u> Business name <u> </u> License No. <u> </u> Address <u>RR 3 Hutchinson</u> Signed <u>John Davenport</u> Date <u>8-9-77</u> Authorized representative		

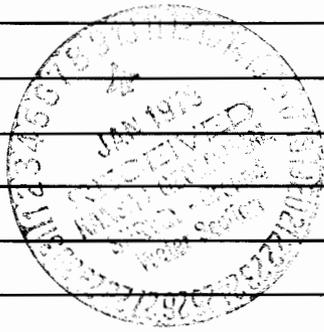

23-50-18 SW SW SW
T R S Sec