


1 LOCATION OF WATER WELL:	Fraction	Section Number	Township Number	Range Number
County: Reno	NE 1/4 SE 1/4 NW 1/4	19	T 23 S S	R 5W E/W

Distance and direction from nearest town or city street address of well if located within city?

50 Highway and 61 1N 1W 1S 1W

2 WATER WELL OWNER: Cargill Salt	Board of Agriculture, Division of Water Resources
RR#, St. Address, Box #: PO Box 1483	Application Number: 37,806
City, State, ZIP Code: Hutchinson, Ks 67501	

3 LOCATE WELL'S LOCATION WITH AN "X" IN SECTION BOX:	4 DEPTH OF COMPLETED WELL: 62' ft. ELEVATION:
--	--

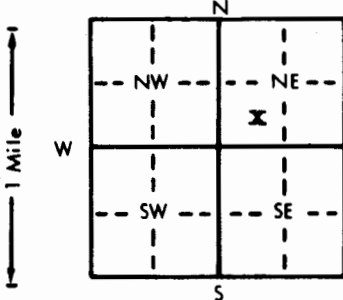

Depth(s) Groundwater Encountered 1. ft. 2. ft. 3. ft.	WELL'S STATIC WATER LEVEL 18' ft. below land surface measured on mo/day/yr 3-24-86
Pump test data: Well water was ft. after hours pumping gpm	Est. Yield gpm: Well water was ft. after hours pumping gpm
Bore Hole Diameter 2 1/2" in. to ft., and in. to ft.	WELL WATER TO BE USED AS:
1 Domestic 3 Feedlot 6 Oil field water supply 9 Dewatering 12 Other (Specify below)	5 Public water supply 8 Air conditioning 11 Injection well
2 Irrigation 4 Industrial 7 Lawn and garden only 10 Observation well	
Was a chemical/bacteriological sample submitted to Department? Yes No X If yes, mo/day/yr sample was submitted	Water Well Disinfected? Yes X No

5 TYPE OF BLANK CASING USED:	5 Wrought iron 8 Concrete tile CASING JOINTS: Glued X Clamped
1 Steel 3 RMP (SR) 6 Asbestos-Cement 9 Other (specify below) Welded X	2 PVC 4 ABS 7 Fiberglass Threaded

Blank casing diameter **16"** in. to **40'** ft., Dia in. to ft., Dia in. to ft.
Casing height above land surface **2'** in., weight lbs./ft. Wall thickness or gauge No.

TYPE OF SCREEN OR PERFORATION MATERIAL:	7 PVC 10 Asbestos-cement
1 Steel 3 Stainless steel 5 Fiberglass 8 RMP (SR) 11 Other (specify)	2 Brass 4 Galvanized steel 6 Concrete tile 9 ABS 12 None used (open hole)

SCREEN OR PERFORATION OPENINGS ARE:	5 Gauzed wrapped 8 Saw cut 11 None (open hole)
1 Continuous slot 3 Mill slot 6 Wire wrapped 9 Drilled holes	2 Louvered shutter 4 Key punched 7 Torch cut 10 Other (specify)

SCREEN-PERFORATED INTERVALS: From 40 ft. to 60 ft., From ft. to ft.	GRAVEL PACK INTERVALS: From 10 ft. to 60 ft., From ft. to ft.
---	---

6 GROUT MATERIAL: 1 Neat cement 2 Cement grout 3 Bentonite 4 Other	Grout Intervals: From 0 ft. to 10 ft., From ft. to ft.
--	--

What is the nearest source of possible contamination: NA	10 Livestock pens 14 Abandoned water well
1 Septic tank 4 Lateral lines 7 Pit privy 11 Fuel storage 15 Oil well/Gas well	2 Sewer lines 5 Cess pool 8 Sewage lagoon 12 Fertilizer storage 16 Other (specify below)
3 Watertight sewer lines 6 Seepage pit 9 Feedyard 13 Insecticide storage	

Direction from well? How many feet?

FROM	TO	LITHOLOGIC LOG	FROM	TO	LITHOLOGIC LOG
0	8	Top Soil			
8	12	Medium Gravel			
12	14	Brown Clay			
14	28	Fine Gravel			
28	40	Medium Gravel			
40	62	Medium Gravel			
62	-	Shale			

7 CONTRACTOR'S OR LANDOWNER'S CERTIFICATION: This water well was (1) constructed, (2) reconstructed, or (3) plugged under my jurisdiction and was completed on (mo/day/year) 3-24-86 and this record is true to the best of my knowledge and belief. Kansas Water Well Contractor's License No. 134 This Water Well Record was completed on (mo/day/yr) by (signature) Mike Davis under the business name of Rosenkrantz-Bemis

INSTRUCTIONS: Use typewriter or ball point pen, PLEASE PRESS FIRMLY and PRINT clearly. Please fill in blanks, underline or circle the correct answers. Send top three copies to Kansas Department of Health and Environment, Division of Environment, Environmental Geology Section, Topeka, KS 66620. Send one to WATER WELL OWNER and retain one for your records.