


1 LOCATION OF WATER WELL:		Fraction		Section Number		Township Number		Range Number		
County:	Reno	E 1/2	1/4	NE	1/4	NE	1/4	22	T 23 S	R 5 E/W

Distance and direction from nearest town or city street address of well if located within city?

1 3/4 east of Hutchinson

2	WATER WELL OWNER:	Clifton Whited	Wheatstate Drilling	
	RR#, St. Address, Box # :	Hutchinson, Ks. 67551	Box 947	Board of Agriculture, Division of Water Resources
	City, State, ZIP Code :		Pratt, Ks. 67124	Application Number: T83-256

3 LOCATE WELL'S LOCATION WITH AN "X" IN SECTION BOX: 4 DEPTH OF COMPLETED WELL... 50 ft. ELEVATION: .....

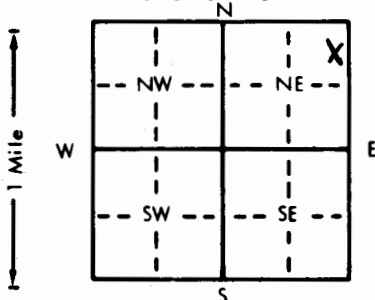

4) DEPTH OF COMPLETED WELL.....50..... ft. ELEVATION:.....  
 Depth(s) Groundwater Encountered 1.....9..... ft. 2..... ft. 3..... ft.  
 WELL'S STATIC WATER LEVEL.....9..... ft. below land surface measured on mo/day/yr 7-6-83  
 Pump test data: Well water was..... ft. after..... hours pumping..... gpm  
 Est. Yield NA..... gpm: Well water was..... ft. after..... hours pumping..... gpm  
 Bore Hole Diameter.....10..... in. to.....50..... ft., and..... in. to..... ft.  
 WELL WATER TO BE USED AS: 5 Public water supply 8 Air conditioning 11 Injection well  
 1 Domestic 3 Feedlot 6 Oil field water supply 9 Dewatering 12 Other (Specify below)  
 2 Irrigation 4 Industrial 7 Lawn and garden only 10 Observation well  
 Was a chemical/bacteriological sample submitted to Department? Yes.....No. x.....; If yes, mo/day/yr sample was sub-  
 mitted Water Well Disinfected? Yes HTH No

5 TYPE OF BLANK CASING USED:		5 Wrought iron	8 Concrete tile	CASING JOINTS: Glued <input checked="" type="checkbox"/> . . . Clamped . . . . .
1 Steel	3 RMP (SR)	6 Asbestos-Cement	9 Other (specify below)	Welded . . . . .
2 PVC	4 ABS	7 Fiberglass		Threaded . . . . .

Blank casing diameter . . . 5 . . . in. to . . . 30 . . . ft., Dia . . . in. to . . . ft., Dia . . . in. to . . . ft.  
Casing height above land surface . . . 18 . . . in., weight . . . lbs./ft. Wall thickness or gauge No. . . 258.

TYPE OF SCREEN OR PERFORATION MATERIAL:			7 PVC	10 Asbestos-cement
1 Steel	3 Stainless steel	5 Fiberglass	<u>8 RMP (SR)</u>	11 Other (specify) .....
2 Brass	4 Galvanized steel	6 Concrete tile	9 ABS	12 None used (open hole)

SCREEN OR PERFORATION OPENINGS ARE:		5 Gauzed wrapped	8 Saw cut	11 None (open hole)
1 Continuous slot	3 Mill slot	6 Wire wrapped	9 Drilled holes	
2 Louvered shutter	4 Key punched	7 Torch cut	10 Other (specify) .....	

SCREEN-PERFORATED INTERVALS:	From . . . . . 30 . . . . . ft. to . . . 50 . . . . . ft.,	From . . . . . ft. to . . . . . ft.
	From . . . . . ft. to . . . . . ft.,	From . . . . . ft. to . . . . . ft.
GRAVEL PACK INTERVALS:	From . . . . . 10 . . . . . ft. to . . . 50 . . . . . ft.,	From . . . . . ft. to . . . . . ft.
	From . . . . . ft. to . . . . . ft.,	From . . . . . ft. to . . . . . ft.

6 GROUT MATERIAL: 1 Neat cement 2 Cement grout 3 Bentonite 4 Other  
Grout Intervals: From 0 ft. to 10 ft. From ft. to ft. From ft. to ft.

What is the nearest source of possible contamination:			10 Livestock pens	14 Abandoned water well
1 Septic tank	4 Lateral lines	7 Pit privy	11 Fuel storage	<u>15 Oil well/Gas well</u>
2 Sewer lines	5 Cess pool	8 Sewage lagoon	12 Fertilizer storage	16 Other (specify below)
3 Watertight sewer lines	6 Seepage pit	9 Feedyard	13 Insecticide storage	.....

Direction from well? west How many feet? 90

[illegible]

7 CONTRACTOR'S OR LANDOWNER'S CERTIFICATION: This water well was (1) constructed, (2) reconstructed, or (3) plugged under my jurisdiction and was completed on (mo/day/year) 7-6-83 and this record is true to the best of my knowledge and belief. Kansas Water Well Contractor's License No. 134 This Water Well Record was completed on (mo/day/yr) 7-16-83

under the business name of Rosencrantz-Bemis Ent. by (signature) Don Carlson  
 INSTRUCTIONS: Use typewriter or ball point pen, PLEASE PRESS FIRMLY and PRINT clearly. Please fill in blanks, underline or circle the correct answers. Send top three copies to Kansas Department of Health and Environment, Division of Environment, Environmental Geology Section, Topeka, KS 66620. Send one to WATER WELL OWNER and retain one for your records.