


1 LOCATION OF WATER WELL: County: <i>Reno.</i>	Fraction: <i>NE 1/4 N1E 1/4 N1E 1/4</i>	Section Number: <i>24</i>	Township Number: <i>T 23 S</i>	Range Number: <i>R 5 E W</i>
---	---	---------------------------	--------------------------------	------------------------------

Distance and direction from nearest town or city street address of well if located within city?  
2 East Hutchinson City limits.

2 WATER WELL OWNER: Majorie Bell  
RR#, St. Address, Box # : R# 4  
City, State, ZIP Code : Hutchinson KS

Board of Agriculture, Division of Water Resources  
Application Number:

3 LOCATE WELL'S LOCATION WITH AN "X" IN SECTION BOX: 4 DEPTH OF COMPLETED WELL... 50 ft. ELEVATION: 14

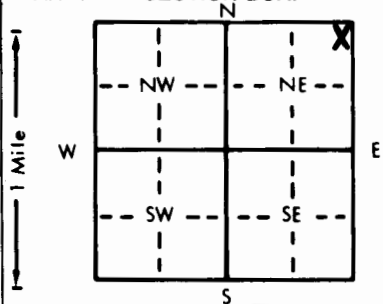

4 DEPTH OF COMPLETED WELL... 50 ft. ELEVATION: ...

Depth(s) Groundwater Encountered 1. 14 ft. 2. ... ft. 3. ... ft.

WELL'S STATIC WATER LEVEL ... 14 ft. below land surface measured on mo/day/yr 5-22-85

Pump test data: Well water was ... 40 ft. after ... 2 hours pumping ... 10 gpm

Est. Yield ... 10 gpm Well water was ... ft. after ... hours pumping ... gpm

Bore Hole Diameter ... 1.1 in. to ... 50 ft., and ... in. to ... ft.

WELL WATER TO BE USED AS:

1 Domestic	3 Feedlot	6 Oil field water supply	8 Air conditioning	11 Injection well
2 Irrigation	4 Industrial	7 Lawn and garden only	9 Dewatering	12 Other (Specify below)
			10 Observation well	

Was a chemical/bacteriological sample submitted to Department? Yes.....No.....X; If yes, mo/day/yr sample was submitted

Water Well Disinfected? Yes X No

5 TYPE OF BLANK CASING USED:	5 Wrought iron	8 Concrete tile	CASING JOINTS: Glued <input checked="" type="checkbox"/> . . . Clamped . . . . .
1 Steel	6 Asbestos-Cement	9 Other (specify below)	Welded . . . . .
2 PVC	7 Fiberglass		Threaded . . . . .
3 RMP (SR)			
4 ABS			

Blank casing diameter 5 in. to 18 ft., Dia. in. to ft., Dia. in. to ft.  
Casing height above land surface 12 in., weight 1.59 lbs./ft. Wall thickness or gauge No. 50R-26

TYPE OF SCREEN OR PERFORATION MATERIAL:				
1 Steel	3 Stainless steel	5 Fiberglass	7 PVC	10 Asbestos-cement
2 Brass	4 Galvanized steel	6 Concrete tile	8 RMP (SR)	11 Other (specify) .....
			9 ABS	12 None used (open hole)

SCREEN OR PERFORATION OPENINGS ARE:

1 Continuous slot	3 Mill slot	5 Gauzed wrapped	8 Saw cut	11 None (open hole)
2 Louvered shutter	4 Key punched	6 Wire wrapped	9 Drilled holes	
		7 Torch cut	10 Other (specify) .....	

SCREEN-PERFORATED INTERVALS:	From	18	ft. to	50	ft., From		ft. to		ft.
	From		ft. to		ft., From		ft. to		ft.
GRAVEL PACK INTERVALS:	From	13	ft. to	50	ft., From		ft. to		ft.
	From		ft. to		ft., From		ft. to		ft.

6 GROUT MATERIAL: 1 Neat cement 2 Cement grout 3 Bentonite 4 Other  
Grout Intervals: From 3 ft. to 13 ft. From ft. to ft. From ft. to ft.

What is the nearest source of possible contamination:

1 Septic tank	4 Lateral lines	7 Pit privy	10 Livestock pens	14 Abandoned water well
2 Sewer lines	5 Cess pool	8 Sewage lagoon	11 Fuel storage	15 Oil well/Gas well
3 Watertight sewer lines	6 Seepage pit	9 Feedyard	12 Fertilizer storage	16 Other (specify below)
			13 Insecticide storage	.....

Direction from well? S.W. How many feet? 80

[illegible]

7 CONTRACTOR'S OR LANDOWNER'S CERTIFICATION: This water well was (1) constructed, (2) reconstructed, or (3) plugged under my jurisdiction and was completed on (mo/day/year) 5-22-85 and this record is true to the best of my knowledge and belief. Kansas Water Well Contractor's License No. 318 This Water Well Record was completed on (mo/day/yr) 6-25-85 under the business name of Wenger & Dutton by (signature) [Signature]

INSTRUCTIONS: Use typewriter or ball point pen, PLEASE PRESS FIRMLY and PRINT clearly. Please fill in blanks, underline or circle the correct answers. Send top three copies to Kansas Department of Health and Environment, Division of Environment, Environmental Geology Section, Topeka, KS 66620. Send one to WATER WELL OWNER and retain one for your records.