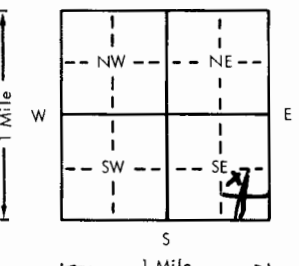
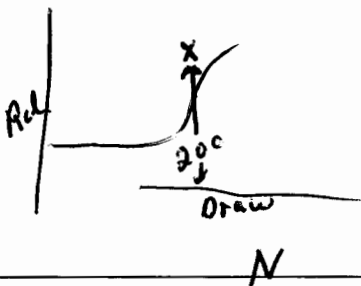


USE TYPEWRITER OR BALL
POINT PEN-PRESS FIRMLY,
PRINT CLEARLY.

WATER WELL RECORD
KSA 82a-1201-1215

Kansas Department of Health and
Environment-Division of Environment
(Water well Contractors)
Topeka, Kansas 66620

1. Location of well:		County Aeno	Fraction NW 1/4 SE 1/4 SE 1/4	Section number 30	Township number T 23	Range number S R 5
2. Distance and direction from nearest town or city: 2 mi S of Hutchinson, KS		3. Owner of well: Al Stucky R.R. or street: RR 4 City, state, zip code: Hutchinson, KS 67501				
4. Locate with "X" in section below:		Sketch map:				
						
5. Type and color of material		From	To	6. Bore hole dia. 16 in. Completion date 8-5-77 Well depth 38 ft. 600 DOW		
Dune Sand		0	10	7. <input checked="" type="checkbox"/> Cable tool <input checked="" type="checkbox"/> Rotary <input type="checkbox"/> Driven <input type="checkbox"/> Dug <input type="checkbox"/> Hollow rod <input type="checkbox"/> Jetted <input type="checkbox"/> Bored <input type="checkbox"/> Reverse rotary		
Sand		10	15	8. Use: <input checked="" type="checkbox"/> Domestic <input type="checkbox"/> Public supply <input type="checkbox"/> Industry <input type="checkbox"/> Irrigation <input type="checkbox"/> Air conditioning <input type="checkbox"/> Stock <input type="checkbox"/> Lawn <input type="checkbox"/> Oil field water <input type="checkbox"/> Other		
Course Sand		15	43	9. Casing: Material P15T Height Above or below Threaded <input type="checkbox"/> Welded <input type="checkbox"/> Surface 14 in. RMP <input checked="" type="checkbox"/> PVC <input type="checkbox"/> Weight 1.95 lbs./ft. Dia. 6 in. to 38 ft. depth Wall Thickness: inches or Dia. <input type="checkbox"/> in. to <input type="checkbox"/> ft. depth gage No. 200		
				10. Screen: Manufacturer's name J+L Type RMP Dia. 6 Slot gauge .060 Length 10' Set between 28 ft. and 38 ft. ft. and <input type="checkbox"/> ft. Gravel pack? <input checked="" type="checkbox"/> Size range of material F-5		
				11. Static water level: <input type="checkbox"/> mo./day/yr. 13 ft. below land surface Date 8-5-77		
				12. Pumping level below land surfaces: 14 ft. after 2 hrs. pumping 20 g.p.m. ft. after <input type="checkbox"/> hrs. pumping <input type="checkbox"/> g.p.m. Estimated maximum yield 40 g.p.m.		
				13. Water sample submitted: <input type="checkbox"/> mo./day/yr. <input type="checkbox"/> Yes <input checked="" type="checkbox"/> No Date <input type="checkbox"/>		
				14. Well head completion: <input type="checkbox"/> Pitless adapter 14 inches above grade		
				15. Well grouted? <input checked="" type="checkbox"/> Yes With: <input checked="" type="checkbox"/> Neat cement <input type="checkbox"/> Bentonite <input type="checkbox"/> Concrete Depth: From 3 ft. to 13 ft.		
				16. Nearest source of possible contamination: See Note ft. 200 Direction N Type Draw Well disinfected upon completion? <input checked="" type="checkbox"/> Yes <input type="checkbox"/> No		
				17. Pump: <input checked="" type="checkbox"/> Not installed Manufacturer's name <input type="checkbox"/> Model number <input type="checkbox"/> HP <input type="checkbox"/> Volts <input type="checkbox"/> Length of drop pipe <input type="checkbox"/> ft. capacity <input type="checkbox"/> g.p.m. Type: <input type="checkbox"/> Submersible <input type="checkbox"/> Turbine <input type="checkbox"/> Jet <input type="checkbox"/> Reciprocating <input type="checkbox"/> Centrifugal <input type="checkbox"/> Other		
		(Use a second sheet if needed)				
18. Elevation:		19. Remarks: To become future Building site			20. Water well contractor's certification: This well was drilled under my jurisdiction and this report is true to the best of my knowledge and belief. Miller Water Well 137 Business name Hutchinson, KS License No. Address Joe Miller 6-15-78 Signed Joe Miller Date 6-15-78 Authorized representative	