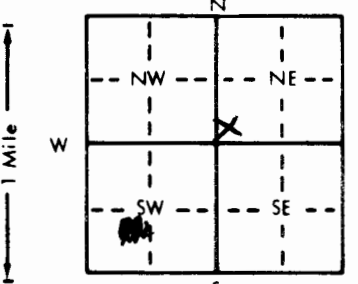


1 LOCATION OF WATER WELL: County: RENO	Fraction SW 1/4 SW 1/4 NE 1/4	Section Number 30	Township Number T 23 S	Range Number R 5 EW
--	---	-----------------------------	----------------------------------	-------------------------------

Distance and direction from nearest town or city street address of well if located within city?

Gruber West Star Truck Stop, 2212 US Hwy 50, Hutchinson, KS (mw-4)

2 WATER WELL OWNER: JAYHAWK CORP. RR#, St. Address, Box # : PO BOX 8216 City, State, ZIP Code : WACO TX 67502	Board of Agriculture, Division of Water Resources Application Number:
--	--

3 LOCATE WELL'S LOCATION WITH AN "X" IN SECTION BOX: 	4 DEPTH OF COMPLETED WELL: 13.5 ft. ELEVATION: 1516.97 Depth(s) Groundwater Encountered 1. 6.0 ft. 2. 6.0 ft. 3. 6.0 ft. WELL'S STATIC WATER LEVEL 6.3 ft. below land surface measured on mo/day/yr 5-13-93 Pump test data: Well water was 6.3 ft. after 5 hours pumping 5 gpm Est. Yield 5 gpm: Well water was 6.3 ft. after 5 hours pumping 5 gpm Bore Hole Diameter 8 in. to 15.5 ft. and 15.5 in. to 15.5 ft. WELL WATER TO BE USED AS: 1 Domestic 3 Feedlot 6 Oil field water supply 9 Dewatering 12 Other (Specify below) 2 Irrigation 4 Industrial 7 Lawn and garden only 10 Monitoring well Was a chemical/bacteriological sample submitted to Department? Yes X No No If yes, mo/day/yr sample was submitted Water Well Disinfected? Yes No
--	--

5 TYPE OF BLANK CASING USED: 1 Steel 3 RMP (SR) 5 Wrought iron 8 Concrete tile 2 PVC 4 ABS 6 Asbestos-Cement 9 Other (specify below) Blank casing diameter 2 in. to 3.5 ft. Dia 3.5 in. to 3.5 ft. Dia 3.5 in. to 3.5 ft. Casing height above land surface 3 in. weight 3 lbs./ft. Wall thickness or gauge No. 40 TYPE OF SCREEN OR PERFORATION MATERIAL: 1 Steel 3 Stainless steel 5 Fiberglass 8 RMP (SR) 10 Asbestos-cement 2 Brass 4 Galvanized steel 6 Concrete tile 9 ABS 11 Other (specify) 12 None used (open hole) SCREEN OR PERFORATION OPENINGS ARE: 1 Continuous slot 3 Mill slot 5 Gauzed wrapped 8 Saw cut 11 None (open hole) 2 Louvered shutter 4 Key punched 6 Wire wrapped 9 Drilled holes 3 Torch cut 10 Other (specify) SCREEN-PERFORATED INTERVALS: From 13.5 ft. to 3.5 ft. From 3.5 ft. to 3.5 ft. GRAVEL PACK INTERVALS: From 15.5 ft. to 2.5 ft. From 2.5 ft. to 2.5 ft.
--

6 GROUT MATERIAL: 1 Neat cement 2 Cement grout 3 Bentonite 4 Other Grout Intervals: From 2.5 ft. to 0 ft. From 0 ft. to 0 ft. From 0 ft. to 0 ft. What is the nearest source of possible contamination: 1 Septic tank 4 Lateral lines 7 Pit privy 11 Fuel storage 14 Abandoned water well 2 Sewer lines 5 Cess pool 8 Sewage lagoon 12 Fertilizer storage 15 Oil well/Gas well 3 Watertight sewer lines 6 Seepage pit 9 Feedyard 13 Insecticide storage 16 Other (specify below) Direction from well? West How many feet? 40

FROM	TO	LITHOLOGIC LOG	FROM	TO	PLUGGING INTERVALS
0.0	1.0	Gravel			
1.0	2.5	Dark Grey Silty Clay			
2.5	9.5	Grey Lt Brown Sand & some clay			
9.5	11.0	Grey Brown Fine Grain Sand			
11.0	15.5	Grey Med-Coarse Grain Sand			

7 CONTRACTOR'S OR LANDOWNER'S CERTIFICATION: This water well was 1 constructed, (2) reconstructed, or (3) plugged under my jurisdiction and was completed on (mo/day/year) 5/11/93 and this record is true to the best of my knowledge and belief. Kansas Water Well Contractor's License No. 416 This Water Well Record was completed on (mo/day/yr) 5/25/93 under the business name of Terracon by (signature) Ronald G. Gillette
