


1 LOCATION OF WATER WELL: Fraction NE 1/4 NW 1/4 SW 1/4 Section Number 33 Township Number T 23 S Range Number R 5 E  
County: Reno

Distance and direction from nearest town or city street address of well if located within city?

at Hutchinson Treatment Plant 3 mis. S. + 1/2 mi. E.

2 WATER WELL OWNER: City of Hutchinson, KS, 125 E. Ave "B" Hutchinson, KS 67501  
RR#, St. Address, Box #: 125 E. Ave "B"  
City, State, ZIP Code: Hutchinson, KS 67501  
Board of Agriculture, Division of Water Resources  
Application Number: 36,592

3 LOCATE WELL'S LOCATION WITH AN "X" IN SECTION BOX: 4 DEPTH OF COMPLETED WELL 52 ft. ELEVATION: 7.8 ft.

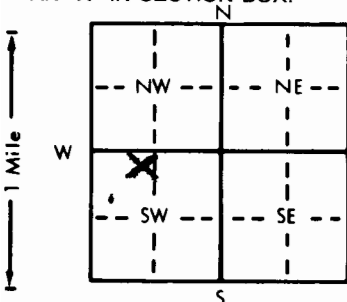

Depth(s) Groundwater Encountered 1 ft. 2 ft. 3 ft.

WELL'S STATIC WATER LEVEL 8.0 ft. below land surface measured on mo/day/yr 4/29/83

Pump test data: Well water was 14.6 ft. after 24 hours pumping 900 gpm

Est. Yield 1,000 gpm Well water was 52 ft. after 24 hours pumping 900 gpm

Bore Hole Diameter 30 in. to 52 ft., and 52 in. to 52 ft.

WELL WATER TO BE USED AS: 5 Public water supply 8 Air conditioning 11 Injection well

1 Domestic 3 Feedlot 6 Oil field water supply 9 Dewatering 12 Other (Specify below)

2 Irrigation 4 Industrial 7 Lawn and garden only 10 Observation well

Was a chemical/bacteriological sample submitted to Department? Yes X No X If yes, mo/day/yr sample was submitted

Water Well Disinfected? Yes X No X

5 TYPE OF BLANK CASING USED: 5 Wrought iron 8 Concrete tile CASING JOINTS: Glued X Clamped X

1 Steel 3 RMP (SR) 6 Asbestos-Cement 9 Other (specify below) Welded X

2 PVC 4 ABS 7 Fiberglass Threaded X

Blank casing diameter 16 in. to 10 ft. Dia 14 in. to 24.25 ft. Dia 188 ft.

Casing height above land surface 14 in. weight 24.25 lbs./ft. Wall thickness or gauge No. 188

TYPE OF SCREEN OR PERFORATION MATERIAL: 7 PVC 10 Asbestos-cement

1 Steel 3 Stainless steel 5 Fiberglass 8 RMP (SR) 11 Other (specify)

2 Brass 4 Galvanized steel 6 Concrete tile 9 ABS 12 None used (open hole)

SCREEN OR PERFORATION OPENINGS ARE: 5 Gauzed wrapped 8 Saw cut 11 None (open hole)

1 Continuous slot 3 Mill slot 6 Wire wrapped 9 Drilled holes

2 Louvered shutter 4 Key punched 7 Torch cut 10 Other (specify)

SCREEN-PERFORATED INTERVALS: From 10 ft. to 50 ft. From 5 ft. to 52 ft.

GRAVEL PACK INTERVALS: From 5 ft. to 52 ft. From 5 ft. to 52 ft.

6 GROUT MATERIAL: 1 Neat cement 2 Cement grout 3 Bentonite 4 Other compacted clay

Grout Intervals: From 0 ft. to 5 ft. From 5 ft. to 52 ft. From 5 ft. to 52 ft.

What is the nearest source of possible contamination: 10 Livestock pens 14 Abandoned water well

1 Septic tank 4 Lateral lines 7 Pit privy 11 Fuel storage 15 Oil well/Gas well

2 Sewer lines 5 Cess pool 8 Sewage lagoon 12 Fertilizer storage 16 Other (specify below)

3 Watertight sewer lines 6 Seepage pit 9 Feedyard 13 Insecticide storage

Direction from well? South-Southwest How many feet? 850

FROM TO LITHOLOGIC LOG FROM TO LITHOLOGIC LOG

0 2 top soil 0 2 top soil

2 8 fine sand 2 8 fine sand

8 25 fine to coarse sand 8 25 fine to coarse sand

25 39 coarse sand 25 39 coarse sand

39 41 soil 39 41 soil

41 50 coarse sand 41 50 coarse sand

7 CONTRACTOR'S OR LANDOWNER'S CERTIFICATION: This water well was (1) constructed (2) reconstructed, or (3) plugged under my jurisdiction and was

completed on (mo/day/year) 4/29/83 and this record is true to the best of my knowledge and belief. Kansas

Water Well Contractor's License No. 139 This Water Well Record was completed on (mo/day/yr) 6/24/83

under the business name of Subgrade Coret, Co. by (signature) Wayne D. Burson

INSTRUCTIONS: Use typewriter or ball point pen, PLEASE PRESS FIRMLY and PRINT clearly. Please fill in blanks, underline or circle the correct answers. Send top

three copies to Kansas Department of Health and Environment, Division of Environment, Environmental Geology Section, Topeka, KS 66620. Send one to WATER WELL

OWNER and retain one for your records.