

LOCATION OF WATER WELL:		Fraction	Section Number	Township Number	Range Number
County: Reno		NE 1/4 SW 1/4 SW 1/4	35	T 23 S	R 5W E/W


Distance and direction from nearest town or city street address of well if located within city?

4 N, 1 E of Yoder, Kansas

WATER WELL OWNER: M. A. Bacon	Lobo Drilling	Bacon #2
RR#, St. Address, Box #: Route 4	Box 877	Board of Agriculture, Division of Water Resources
City, State, ZIP Code: Hutchinson, Ks. 67501	Great Bend, Ks. 67530	Application Number: Unknown

LOCATE WELL'S LOCATION WITH AN "X" IN SECTION BOX:

DEPTH OF COMPLETED WELL... 45 ft. ELEVATION: Unknown

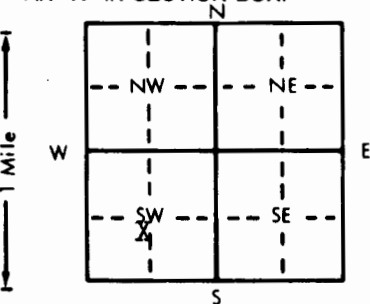

Depth(s) Groundwater Encountered 1. 12 ft. 2. ft. 3. ft.

WELL'S STATIC WATER LEVEL 12 ft. below land surface measured on mo/day/yr 11/29/85

Pump test data: Well water was ft. after hours pumping gpm

Est. Yield 60 gpm: Well water was ft. after hours pumping gpm

Bore Hole Diameter 8 in. to 45 ft., and in. to ft.

WELL WATER TO BE USED AS:

1 Domestic	3 Feedlot	6 Oil field water supply	9 Air conditioning	11 Injection well
2 Irrigation	4 Industrial	7 Lawn and garden only	10 Dewatering	12 Other (Specify below)

Was a chemical/bacteriological sample submitted to Department? Yes No; If yes, mo/day/yr sample was submitted

Water Well Disinfected? Yes No

5 TYPE OF BLANK CASING USED:

5 Wrought iron	8 Concrete tile	CASING JOINTS: <u>Glued</u> Clamped Welded Threaded
6 Asbestos-Cement	9 Other (specify below)	
7 Fiberglass		

Blank casing diameter 5 in. to 25 ft., Dia in. to ft., Dia in. to ft.
Casing height above land surface 12 in., weight 2.8 lbs./ft. Wall thickness or gauge No. Sch. 40

TYPE OF SCREEN OR PERFORATION MATERIAL:

	7 <u>PVC</u>	10 Asbestos-cement
5 Fiberglass	8 RMP (SR)	11 Other (specify)
6 Concrete tile	9 ABS	12 None used (open hole)

SCREEN OR PERFORATION OPENINGS ARE:

5 Gauzed wrapped 8 Saw cut 11 None (open hole)
6 Wire wrapped 9 Drilled holes
7 Torch cut 10 Other (specify)

SCREEN-PERFORATED INTERVALS:

From 25	ft. to 45	ft., From	ft. to	ft.
From	ft. to	ft., From	ft. to	ft.
From 10	ft. to 45	ft., From	ft. to	ft.
From	ft. to	ft., From	ft. to	ft.

6 GROUT MATERIAL:

1 Neat cement	2 Cement grout	3 Bentonite	4 Other
---------------	----------------	-------------	---------------

Grout Intervals: From 0 ft. to 10 ft., From _____ ft. to _____ ft., From _____ ft. to _____ ft.

What is the nearest source of possible contamination:

7 Pit privy	10 Livestock pens	14 Abandoned water well
8 Sewage lagoon	11 Fuel storage	15 <u>Oil well/Gas well</u>
9 Feedyard	12 Fertilizer storage	16 Other (specify below)
	13 Insecticide storage

Direction from well?

South

How many feet? 60

[illegible]

7] CONTRACTOR'S OR LANDOWNER'S CERTIFICATION: This water well was (1) constructed, (2) reconstructed, or (3) plugged under my jurisdiction and was completed on (mo/day/year) 11/29/85 and this record is true to the best of my knowledge and belief. Kansas

Water Well Contractor's License No.186..... This Water Well Record was completed on (mo/day/yr)1/20/86
under the business name of Kelly's Water Well Service by (signature) [Signature]
INSTRUCTIONS: Use typewriter or ball point pen, PLEASE PRESS FIRMLY and PRINT clearly. Please fill in blanks, underline or circle the correct answers. Send top
three copies to Kansas Department of Health and Environment, Division of Environment, Environmental Geology Section, Topeka, KS 66620. Send one to WATER WELL
OWNER and retain one for your records.