

WATER WELL RECORD Form WWC-5

Original Record Correction Change in Well Use

Division of Water Resources App. No.


20190226

West well

Well ID

1 LOCATION OF WATER WELL: County: Reno	Fraction SE ¼ SE ¼ NW ¼ SE ¼	Section Number 16	Township Number T 23 S	Range Number R 5 <input type="checkbox"/> E <input checked="" type="checkbox"/> W
--	---------------------------------	----------------------	---------------------------	--

2 WELL OWNER: Last Name: Business: Hutchinson Salt Company Inc. Address: P.O. Bx 377 Address: City: Baxter Springs State: Ks. ZIP: 66713	First: Street or Rural Address where well is located (if unknown, distance and direction from nearest town or intersection): If at owner's address, check here: <input type="checkbox"/> 3300 Cary Blvd Hutchinson, Ks. 67501
---	---

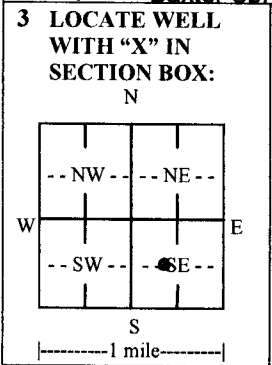

4 DEPTH OF COMPLETED WELL: 32 ft.

Depth(s) Groundwater Encountered: 1) ft.
 2) ft. 3) ft., or 4) Dry Well

WELL'S STATIC WATER LEVEL: 8 ft.
 below land surface, measured on (mo-day-yr) 8/27/2019
 above land surface, measured on (mo-day-yr)

Pump test data: Well water was ft.
 after hours pumping gpm
 Well water was ft.
 after hours pumping gpm

Estimated Yield: gpm
 Bore Hole Diameter: 16 in. to 35 ft. and
 in. to ft.

5 Latitude: 38.04671 (decimal degrees)
Longitude: 097.87164 (decimal degrees)
 Horizontal Datum: WGS 84 NAD 83 NAD 27
 Source for Latitude/Longitude:
 GPS (unit make/model: **Garman 62S**
 (WAAS enabled? Yes No)
 Land Survey Topographic Map
 Online Mapper:

6 Elevation: 1544 ft. Ground Level TOC
 Source: Land Survey GPS Topographic Map
 Other

7 WELL WATER TO BE USED AS:

1. Domestic: <input type="checkbox"/> Household <input type="checkbox"/> Lawn & Garden <input type="checkbox"/> Livestock	2. <input type="checkbox"/> Irrigation	3. <input type="checkbox"/> Feedlot	4. <input type="checkbox"/> Industrial	5. <input type="checkbox"/> Public Water Supply: well ID	6. <input checked="" type="checkbox"/> Dewatering: how many wells?	7. <input type="checkbox"/> Aquifer Recharge: well ID	8. <input type="checkbox"/> Monitoring: well ID	9. Environmental Remediation: well ID	10. <input type="checkbox"/> Oil Field Water Supply: lease	11. Test Hole: well ID	12. Geothermal: how many bores?	13. <input type="checkbox"/> Other (specify):
--	--	-------------------------------------	--	--	--	---	---	---	--	------------------------------	---------------------------------------	---

Was a chemical/bacteriological sample submitted to KDHE? Yes No If yes, date sample was submitted:

Water well disinfected? Yes No

8 TYPE OF CASING USED: Steel PVC Other CASING JOINTS: Glued Clamped Welded Threaded

Casing diameter 10 in. to 12 ft., Diameter in. to ft., Diameter in. to ft.

Casing height above land surface 18 in. Weight SDR 26 lbs./ft. Wall thickness or gauge No. 413

TYPE OF SCREEN OR PERFORATION MATERIAL:

<input type="checkbox"/> Steel	<input type="checkbox"/> Stainless Steel	<input type="checkbox"/> Fiberglass	<input checked="" type="checkbox"/> PVC	<input type="checkbox"/> Other (Specify)
<input type="checkbox"/> Brass	<input type="checkbox"/> Galvanized Steel	<input type="checkbox"/> Concrete tile	<input type="checkbox"/> None used (open hole)	

SCREEN OR PERFORATION OPENINGS ARE:

<input type="checkbox"/> Continuous Slot	<input checked="" type="checkbox"/> Mill Slot	<input type="checkbox"/> Gauze Wrapped	<input type="checkbox"/> Torch Cut	<input type="checkbox"/> Drilled Holes	<input type="checkbox"/> Other (Specify)
<input type="checkbox"/> Louvered Shutter	<input type="checkbox"/> Key Punched	<input type="checkbox"/> Wire Wrapped	<input type="checkbox"/> Saw Cut	<input type="checkbox"/> None (Open Hole)	

SCREEN-PERFORATED INTERVALS: From 12 ft. to 32 ft., From ft. to ft., From ft. to ft.

GRAVEL PACK INTERVALS: From 32 ft. to 10 ft., From ft. to ft., From ft. to ft.

9 GROUT MATERIAL: Neat cement Cement grout Bentonite Other

Grout Intervals: From 10 ft. to 0 ft., From ft. to ft., From ft. to ft.

Nearest source of possible contamination:

<input type="checkbox"/> Septic Tank	<input type="checkbox"/> Lateral Lines	<input type="checkbox"/> Pit Privy	<input type="checkbox"/> Livestock Pens	<input type="checkbox"/> Insecticide Storage
<input type="checkbox"/> Sewer Lines	<input type="checkbox"/> Cess Pool	<input type="checkbox"/> Sewage Lagoon	<input type="checkbox"/> Fuel Storage	<input type="checkbox"/> Abandoned Water Well
<input checked="" type="checkbox"/> Watertight Sewer Lines	<input type="checkbox"/> Seepage Pit	<input type="checkbox"/> Feedyard	<input type="checkbox"/> Fertilizer Storage	<input type="checkbox"/> Oil Well/Gas Well

Other (Specify)

Direction from well? West Distance from well? 6' ft.

10 FROM	TO	LITHOLOGIC LOG	FROM	TO	LITHO. LOG (cont.) or PLUGGING INTERVALS
0	5	Top soil sandy clay			
5	20	Course sand & gravel			
20	35	Fine sand & gravel			

11 CONTRACTOR'S OR LANDOWNER'S CERTIFICATION: This water well was constructed, reconstructed, or plugged under my jurisdiction and was completed on (mo-day-year) 8/27/2019 and this record is true to the best of my knowledge and belief. Kansas Water Well Contractor's License No. 134 This Water Well Record was completed on (mo-day-year) 9/3/2019 under the business name of Rosenkrantz-Bemis Ent. Signature C. J. Cunniff