

# WATER WELL PLUGGING RECORD Form WWC-5P

KSA 82a-1212

ID NO.

LHMW-7i

**1 LOCATION OF WATER WELL:** Fraction nw 1/4 ne 1/4 sw 1/4 nw 1/4 Section Number 9 Township Number T 23 S Range Number 5 ☐ E ☒ W  
County: Reno

Street/Rural Address of Well Location; if unknown, distance & direction from nearest town or intersection: If at owner's address, check here ☐ 815 ft. east and 410 ft. south of intersection of E 14th Ave. and N Halstead St., Hutchinson, KS.


## Global Positioning Systems (GPS) information:

Latitude: 38.0684 (in decimal degrees)  
Longitude: -97.8826 (in decimal degrees)  
Elevation: 1528  
Horizontal Datum: ☒ WGS84, ☐ NAD83, ☐ NAD27  
Collection Method:

**2 WATER WELL OWNER:** Lowen Corp.  
RR#, St. Address, Box #: 1111 Airport Rd.  
City, State ZIP Code: Hutchinson, KS 67501

☐ GPS unit (Make/Model): \_\_\_\_\_  
☒ Digital Map/Photo, ☐ Topographic Map, ☐ Land Survey  
Est. Accuracy: ☐ < 3 m, ☒ 3-5 m, ☐ 5-15 m, ☐ > 15 m

## 3 MARK WELL'S LOCATION WITH AN "X" IN SECTION BOX:

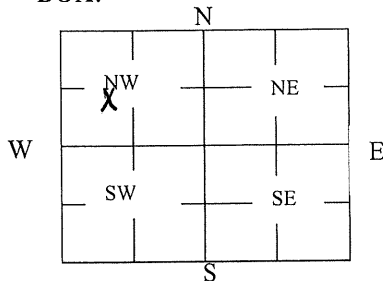

## 4 DEPTH OF WELL 46 ft.

WELL'S STATIC WATER LEVEL 12.6 ft

WELL WAS USED AS:

- |                                     |   |  |
|-------------------------------------|---|--|
| <input type="checkbox"/> Domestic   | <input type="checkbox"/> Public Water Supply      | <input type="checkbox"/> Dewatering            |
| <input type="checkbox"/> Irrigation | <input type="checkbox"/> Oil Field Water Supply   | <input checked="" type="checkbox"/> Monitoring |
| <input type="checkbox"/> Feedlot    | <input type="checkbox"/> Domestic (Lawn & Garden) | <input type="checkbox"/> Injection Well        |
| <input type="checkbox"/> Industrial | <input type="checkbox"/> Air Conditioning         | <input type="checkbox"/> Other _____           |

Was a chemical/bacteriological sample submitted to Department? Yes ☐ No ☒

## 5 TYPE OF BLANK CASING USED:

- ☐ Steel ☐ RMP (SR) ☐ Wrought ☐ Fiberglass ☒ Other (Specify below) \_\_\_\_\_  
☒ PVC ☐ ABS ☐ Asbestos-Cement ☐ Concrete Tile

Blank casing diameter .5 in. Was casing pulled? Yes ☒ No ☐ If yes, how much 3'  
Casing height above or below land surface 3 Ft BD

## 6 GROUT PLUG MATERIAL: ☐ Neat cement ☐ Cement grout ☒ Bentonite ☐ Other \_\_\_\_\_

Grout Plug Intervals: From 0 ft. to 46 ft., From \_\_\_\_\_ ft. to \_\_\_\_\_ ft., From \_\_\_\_\_ ft. to \_\_\_\_\_ ft.

What is the nearest source of possible contamination:

- |   |   |   |   |
|---|---|---|---|
| <input type="checkbox"/> Septic tank            | <input type="checkbox"/> Seepage pit    | <input type="checkbox"/> Fuel storage         | <input checked="" type="checkbox"/> Other (specify below) |
| <input type="checkbox"/> Sewer lines            | <input type="checkbox"/> Pit privy      | <input type="checkbox"/> Fertilizer storage   | <u>Manufacturing Facility</u>                             |
| <input type="checkbox"/> Watertight sewer lines | <input type="checkbox"/> Sewage lagoon  | <input type="checkbox"/> Insecticide storage  |   |
| <input type="checkbox"/> Lateral lines          | <input type="checkbox"/> Feedyard       | <input type="checkbox"/> Abandoned water well | Direction from well? <u>nw</u>                            |
| <input type="checkbox"/> Cess pool              | <input type="checkbox"/> Livestock pens | <input type="checkbox"/> Oil well/Gas well    | How many feet? <u>1550'</u>                               |

FROM	TO	PLUGGING MATERIALS	FROM	TO	PLUGGING MATERIALS
0	46	Bentonite			

**7 CONTRACTOR'S OR LANDOWNER'S CERTIFICATION:** This water well was plugged under my jurisdiction and was completed on (mo/day/year) 10/27/23 and this record is true to the best of my knowledge and belief. Kansas Water Well Contractor's License No. 527. This Water Well Record was completed on (mo/day/year) 11/27/2023 under the business name of GeoCore, LLC by (signature) Dale Pelt

Send one white copy to Kansas Department of Health & Environment, Geology Section, 1000 SW Jackson Street, Ste. 420, Topeka, KS 66612-1367. Send one copy to WATER WELL OWNER and retain one for your records.  
Visit us at <http://www.kdheks.gov/waterwell/index.html> Telephone 785-296-5524.

KSA82a-1212

Revised 1/20/2015