

WATER WELL PLUGGING RECORD Form WWC-5P

KSA 82a-1212

ID NO.

LHMW-9d

1 LOCATION OF WATER WELL: County: Reno Fraction ne 1/4 nw 1/4 ne 1/4 ne 1/4 Section Number 8 Township Number T 23 S Range Number 5 ☐ E ☒ W

Street/Rural Address of Well Location; if unknown, distance & direction from nearest town or intersection: If at owner's address, check here ☐ 825 ft. west and 60 ft. south of intersection of E 17th Ave. and N Halstead St., Hutchinson, KS.


Global Positioning Systems (GPS) information:

Latitude: 38.0720 (in decimal degrees)
Longitude: -97.8884 (in decimal degrees)
Elevation: 1528
Horizontal Datum: ☒ WGS84, ☐ NAD83, ☐ NAD27
Collection Method:

2 WATER WELL OWNER: Lowen Corp.
RR#, St. Address, Box #: 1111 Airport Rd.
City, State ZIP Code: Hutchinson, KS 67501

☐ GPS unit (Make/Model: _____)
☒ Digital Map/Photo, ☐ Topographic Map, ☐ Land Survey
Est. Accuracy: ☐ < 3 m, ☒ 3-5 m, ☐ 5-15 m, ☐ > 15 m

3 MARK WELL'S LOCATION WITH AN "X" IN SECTION BOX:

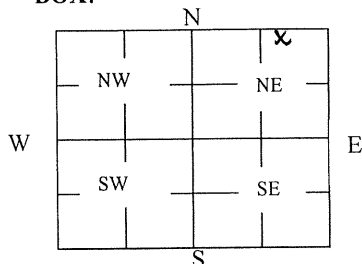

4 DEPTH OF WELL 61 ft.

WELL'S STATIC WATER LEVEL 11.7 ft

WELL WAS USED AS:

☐ Domestic ☐ Public Water Supply ☐ Dewatering
☐ Irrigation ☐ Oil Field Water Supply ☒ Monitoring
☐ Feedlot ☐ Domestic (Lawn & Garden) ☐ Injection Well
☐ Industrial ☐ Air Conditioning ☐ Other _____

Was a chemical/bacteriological sample submitted to Department? Yes ☐ No ☒

5 TYPE OF BLANK CASING USED:

☐ Steel ☐ RMP (SR) ☐ Wrought ☐ Fiberglass ☒ Other (Specify below)
☒ PVC ☐ ABS ☐ Asbestos-Cement ☐ Concrete Tile

Blank casing diameter .5 in. Was casing pulled? Yes ☒ No ☐ If yes, how much 8'
Casing height above or below land surface 0 8 ft in.
BDA

6 GROUT PLUG MATERIAL: ☐ Neat cement ☐ Cement grout ☒ Bentonite ☐ Other _____

Grout Plug Intervals: From 0 ft. to 61 ft., From _____ ft. to _____ ft., From _____ ft. to _____ ft.

What is the nearest source of possible contamination:

☐ Septic tank ☐ Seepage pit ☐ Fuel storage ☒ Other (specify below)
☐ Sewer lines ☐ Pit privy ☐ Fertilizer storage Manufacturing Facility
☐ Watertight sewer lines ☐ Sewage lagoon ☐ Insecticide storage
☐ Lateral lines ☐ Feedyard ☐ Abandoned water well Direction from well? se
☐ Cess pool ☐ Livestock pens ☐ Oil well/Gas well How many feet? 540'

FROM	TO	PLUGGING MATERIALS	FROM	TO	PLUGGING MATERIALS
0	61	Bentonite			

7 CONTRACTOR'S OR LANDOWNER'S CERTIFICATION: This water well was plugged under my jurisdiction and was completed on (mo/day/year) 10/27/23 and this record is true to the best of my knowledge and belief. Kansas Water Well Contractor's License No. 527. This Water Well Record was completed on (mo/day/year) 11/27/2023 under the business name of GeoCore, LLC by (signature) *Dale Hef*

Send one white copy to Kansas Department of Health & Environment, Geology Section, 1000 SW Jackson Street, Ste. 420, Topeka, KS 66612-1367. Send one copy to WATER WELL OWNER and retain one for your records.
Visit us at <http://www.kdheks.gov/waterwell/index.html> Telephone 785-296-5524.

KSA82a-1212

Revised 1/20/2015