

1 LOCATION OF WATER WELL:		Fraction	Section Number	Township Number	Range Number
County:	Reno	NE $\frac{1}{4}$ NE $\frac{1}{4}$ NE $\frac{1}{4}$	17	T 23 S	R 5 E (W)


Distance and direction from nearest town or city street address of well if located within city?

235' South of the SW corner of E. 4th St. & Halstead St.

2	WATER WELL OWNER:	Hamilton Roofing	
	RR#, St. Address, Box # :	301 N. Halstead	Board of Agriculture, Division of Water Resources
	City, State, ZIP Code :	Hutchinson, Kansas	Application Number:

LOCATE WELL'S LOCATION WITH AN "X" IN SECTION BOX: 4 DEPTH OF COMPLETED WELL.....20.....ft. ELEVATION:

Depth(s) Groundwater Encountered 1.....15.....ft. 2.....ft. 3.....ft.

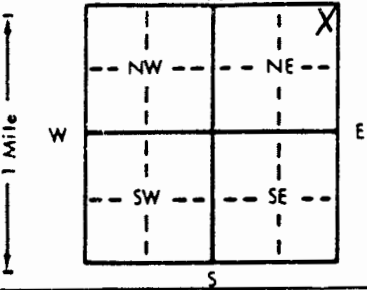

WELL'S STATIC WATER LEVEL . 16.62 . . . ft. below land surface measured on mo/day/yr

Pump test data: Well water was ft. after hours pumping gpm

Est. Yield gpm: Well water was ft. after hours pumping gpm

Bore Hole Diameter . 7.5/8 . . in. to . 20 . . . ft., and in. to . . . ft.

WELL WATER TO BE USED AS:

5 Public water supply	8 Air conditioning	11 Injection well		
1 Domestic	3 Feedlot	6 Oil field water supply	9 Dewatering	12 Other (Specify below)
2 Irrigation	4 Industrial	7 Lawn and garden only	10 Monitoring well	

Was a chemical/bacteriological sample submitted to Department? Yes No X; If yes, mo/day/yr sample was submitted

Water Well Disinfected? Yes No X

5 TYPE OF BLANK CASING USED:

1 Steel	3 RMP (SR)	5 Wrought iron	8 Concrete tile	CASING JOINTS: Glued	Clamped
2 PVC	4 ABS	6 Asbestos-Cement	9 Other (specify below)	Welded	
		7 Fiberglass		Threaded	X

Blank casing diameter 2 in. to 10 ft., Dia. in. to ft., Dia. in. to ft.

Casing height above land surface 0 in., weight lbs./ft. Wall thickness or gauge No. sch 40

TYPE OF SCREEN OR PERFORATION MATERIAL:				
1 Steel	3 Stainless steel	5 Fiberglass	7 PVC	10 Asbestos-cement
2 Brass	4 Galvanized steel	6 Concrete tile	8 RMP (SR)	11 Other (specify)
			9 ABS	12 None used (open hole)

SCREEN OR PERFORATION OPENINGS ARE:

1 Continuous slot	3 Mill slot	5 Gauzed wrapped	8 Saw cut	11 None (open hole)
2 Louvered shutter	4 Key punched	6 Wire wrapped	9 Drilled holes	
		7 Torch cut	10 Other (specify)	

SCREEN-PERFORATED INTERVALS: From 10 ft. to 20 ft., From ft. to ft.
From ft. to ft., From ft. to ft.
GRAVEL PACK INTERVALS: From 8 ft. to 20 ft., From ft. to ft.
From ft. to ft., From ft. to ft.

3] GROUT MATERIAL: 1 Neat cement 2 Cement grout 3 Bentonite 4 Other
Grout Intervals: From ... 0 ... ft. to ... 6 ... ft., From ... 6 ... ft. to ... 8 ... ft., From ... ft. to ... ft.

What is the nearest source of possible contamination:

1 Septic tank	4 Lateral lines	7 Pit privy	10 Livestock pens	14 Abandoned water well
2 Sewer lines	5 Cess pool	8 Sewage lagoon	11 Fuel storage	15 Oil well/Gas well
3 Watertight sewer lines	6 Seepage pit	9 Feedyard	12 Fertilizer storage	16 Other (specify below)
			13 Insecticide storage

Direction from well? East How many feet? 170

FROM	TO	LITHOLOGIC LOG	FROM	TO	PLUGGING INTERVALS
0	1	Roadgrvl & f-c snd, prly srted, damp, v slty sl v drk cly			
1	4	Cly, v drk brn, v slty, sl-mod f-c snd & grvl, damp			
4	9	Cly, med oran-brn, v slty, tr v f-f snd, v plstc, moist			
9	12	Cly, med brn, v slty, v plstc, moist			
12	16	Cly, v drk gry, v plstc, v slty			
16	20	Snd, f-c grnd, v grvly, prly srted, v drk gry, sl cly			
					MW3 - Flushmount
					Don Taylor

CONTRACTOR'S OR LANDOWNER'S CERTIFICATION: This water well was (1) constructed, (2) reconstructed, or (3) plugged under my jurisdiction and was completed on (mo/day/year) 10-20-94 and this record is true to the best of my knowledge and belief. Kansas Water Well Contractor's License No. 527. This Water Well Record was completed on (mo/day/yr) 10-24-94 under the business name of GeoCore Services, Inc. by (signature) [Signature]