


1 LOCATION OF WATER WELL:	Fraction	Section Number	Township Number	Range Number
County: <u>Reno</u>	<u>SE 1/4 NW 1/4 NE 1/4</u>	<u>2</u>	<u>T 23 S</u>	<u>R 5 E</u>

Distance and direction from nearest town or city street address of well if located within city?

2 mi E of Hutchinson on 30th

2 WATER WELL OWNER:	RR#, St. Address, Box # :	City, State, ZIP Code :	Board of Agriculture, Division of Water Resources
<u>Clifford Regier</u>	<u>8511 N Buhler Rd</u>	<u>Buhler, KS 67522</u>	Application Number:

3 LOCATE WELL'S LOCATION WITH AN "X" IN SECTION BOX:	4 DEPTH OF COMPLETED WELL: <u>43</u> ft. ELEVATION:
--	---

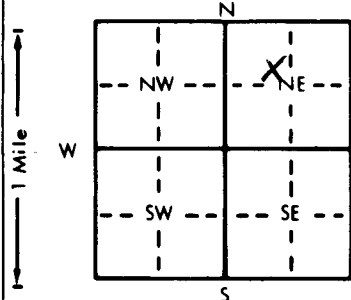

Depth(s) Groundwater Encountered 1. ft. 2. ft. 3. ft.

WELL'S STATIC WATER LEVEL 10 ft. below land surface measured on mo/day/yr 3-16-95Pump test data: Well water was 40 ft. after 1 hours pumping 7 gpmEst. Yield 7 gpm: Well water was 40 ft. after 1 hours pumping 7 gpmBore Hole Diameter 9 in. to 43 ft., and 43 in. to 43 ft.

WELL WATER TO BE USED AS:

5 Public water supply	8 Air conditioning	11 Injection well
1 Domestic	3 Feedlot	6 Oil field water supply
2 Irrigation	4 Industrial	7 Lawn and garden only
		10 Monitoring well

Was a chemical/bacteriological sample submitted to Department? Yes X No X; If yes, mo/day/yr sample was submittedWater Well Disinfected? Yes X No X

5 TYPE OF BLANK CASING USED:	5 Wrought iron	8 Concrete tile	CASING JOINTS: Glued <u>X</u> Clamped
1 Steel	3 RMP (SR)	6 Asbestos-Cement	9 Other (specify below)
2 PVC	4 ABS	7 Fiberglass	Welded
			Threaded

Blank casing diameter 5 in. to 23 ft., Dia 23 in. to 23 ft., Dia 23 in. to 23 ft.Casing height above land surface 24 in., weight 2.29 lbs./ft. Wall thickness or gauge No. 16

TYPE OF SCREEN OR PERFORATION MATERIAL:

1 Steel	3 Stainless steel	5 Fiberglass	8 RMP (SR)	10 Asbestos-cement
2 Brass	4 Galvanized steel	6 Concrete tile	9 ABS	11 Other (specify)
				12 None used (open hole)

SCREEN OR PERFORATION OPENINGS ARE:

1 Continuous slot	3 Mill slot	5 Gauzed wrapped	8 Saw cut	11 None (open hole)
2 Louvered shutter	4 Key punched	6 Wire wrapped	9 Drilled holes	
		7 Torch cut	10 Other (specify)	

SCREEN-PERFORATED INTERVALS: From 23 ft. to 43 ft., From 43 ft. to 43 ft., From 43 ft. to 43 ft.GRAVEL PACK INTERVALS: From 20 ft. to 43 ft., From 43 ft. to 43 ft., From 43 ft. to 43 ft.From 7 CONTRACTOR'S OR LANDOWNER'S CERTIFICATION: This water well was (1) constructed, (2) reconstructed, or (3) plugged under my jurisdiction and was completed on (mo/day/year) <u>3-16-95</u> and this record is true to the best of my knowledge and belief. Kansas Water Well Contractor's License No. <u>447</u> This Water Well Record was completed on (mo/day/yr) <u>3-28-95</u> under the business name of <u>Miller Drilling</u> by (signature) <u>E. Miller</u>
--

INSTRUCTIONS: Use typewriter or ball point pen. PLEASE PRESS FIRMLY and PRINT clearly. Please fill in blanks, underline or circle the correct answers. Send top three copies to Kansas Department of Health and Environment, Bureau of Water, Topeka, Kansas 66620-0001. Telephone: 913-296-5545. Send one to WATER WELL OWNER and retain one for your records.