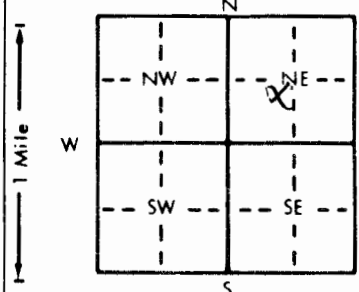


1 LOCATION OF WATER WELL: County: Reno Fraction: NE 1/4 SW 1/4 NE 1/4 Section Number: 4 Township Number: T 23 S Range Number: R 5 E 10
 Distance and direction from nearest town or city street address of well if located within city?

2 WATER WELL OWNER: Dan Johnson
 RR#, St. Address, Box #: 3230 E Meadowlake Dr. Board of Agriculture, Division of Water Resources
 City, State, ZIP Code: Leitchville KS 67503 Application Number:

3 LOCATE WELL'S LOCATION WITH AN "X" IN SECTION BOX: 
 4 DEPTH OF COMPLETED WELL: 80 ft. ELEVATION: 10 ft. below land surface measured on mo/day/yr 4-15-95
 Depth(s) Groundwater Encountered 1. 10 ft. 2. 12 ft. 3. 20 ft.
 WELL'S STATIC WATER LEVEL: 10 ft. below land surface measured on mo/day/yr 4-15-95
 Pump test data: Well water was 50 gpm after 12 hours pumping 20 gpm
 Est. Yield 20+ gpm: Well water was 50 gpm after 12 hours pumping 20 gpm
 Bore Hole Diameter: 10 in. to 45 ft. and 5 in. to 90 ft.
 WELL WATER TO BE USED AS:
 1 Domestic 3 Feedlot 6 Oil field water supply 9 Dewatering 12 Other (Specify below)
 2 Irrigation 4 Industrial 7 Lawn and garden only 10 Monitoring well
 Was a chemical/bacteriological sample submitted to Department? Yes No If yes, mo/day/yr sample was submitted
 Water Well Disinfected? Yes No

5 TYPE OF BLANK CASING USED:
 1 Steel 3 RMP (SR) 5 Wrought iron 8 Concrete tile CASING JOINTS: Glued Clamped
2 PVC 4 ABS 6 Asbestos-Cement 9 Other (specify below) Welded
 7 Fiberglass Threaded
 Blank casing diameter 5 in. to 45 ft. Dia. 50R 26 lbs./ft. Wall thickness or gauge No.
 Casing height above land surface: 14 in., weight 50R 26 lbs./ft. Wall thickness or gauge No.
 TYPE OF SCREEN OR PERFORATION MATERIAL:
 1 Steel 3 Stainless steel 5 Fiberglass 8 RMP (SR) 11 Other (specify)
 2 Brass 4 Galvanized steel 6 Concrete tile 9 ABS 12 None used (open hole)
 SCREEN OR PERFORATION OPENINGS ARE:
 1 Continuous slot 3 Mill slot 5 Gauzed wrapped 8 Saw cut 11 None (open hole)
 2 Louvered shutter 4 Key punched 6 Wire wrapped 9 Drilled holes
 7 Torch cut 10 Other (specify)
 SCREEN-PERFORATED INTERVALS: From NA ft. to NA ft. From NA ft. to NA ft.
 GRAVEL PACK INTERVALS: From NA ft. to NA ft. From NA ft. to NA ft.

6 GROUT MATERIAL: 1 Neat cement 2 Cement grout 3 Bentonite 4 Other
 Grout Intervals: From 40 ft. to 45 ft. From 0 ft. to 20 ft. From NA ft. to NA ft.
 What is the nearest source of possible contamination:
 1 Septic tank 4 Lateral lines 7 Pit privy 10 Livestock pens 14 Abandoned water well
2 Sewer lines 5 Cess pool 8 Sewage lagoon 11 Fuel storage 15 Oil well/Gas well
3 Watertight sewer lines 6 Seepage pit 9 Feedyard 12 Fertilizer storage 16 Other (specify below)
 13 Insecticide storage
 Direction from well? E How many feet? 80

FROM	TO	LITHOLOGIC LOG	FROM	TO	PLUGGING INTERVALS
0	3	Sand			
3	10	Clay			
10	12	Sand			
12	45	Clay			
45	90	Shale			

7 CONTRACTOR'S OR LANDOWNER'S CERTIFICATION: This water well was (1) constructed, (2) reconstructed, or (3) plugged under my jurisdiction and was completed on (mo/day/year) 4-15-95 and this record is true to the best of my knowledge and belief. Kansas
 Water Well Contractor's License No. 4440 This Water Well Record was completed on (mo/day/yr) 5-10-95
 under the business name of Cal Burrell Sons by (signature) Cal Burrell