

1 LOCATION OF WATER WELL: County: Reno	Fraction NE 1/4 NE 1/4 SE 1/4	Section Number 14	Township Number T 23 S	Range Number R 6 EW
---	----------------------------------	----------------------	---------------------------	------------------------

Distance and direction from nearest town or city street address of well if located within city?

305 S. Monroe, Hutchinson, KS.

2 WATER WELL OWNER: David Weast/Krause Plow Corp.


RR#, St. Address, Box #: 305 S. Monroe

Board of Agriculture, Division of Water Resources

City, State, ZIP Code: Hutchinson, KS.

Application Number:

3 LOCATE WELL'S LOCATION WITH AN "X" IN SECTION BOX:

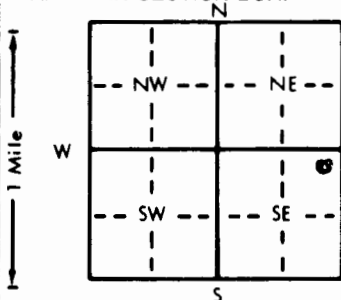

4 DEPTH OF COMPLETED WELL 20'6" ft. ELEVATION:

Depth(s) Groundwater Encountered 1. 11' ft. 2. ft. 3. ft.

WELL'S STATIC WATER LEVEL 11.11 ft. below land surface measured on mo/day/yr 5-22-96

Pump test data: Well water was ft. after hours pumping gpm

Est. Yield gpm: Well water was ft. after hours pumping gpm

Bore Hole Diameter 8 1/2" in. to 20'6" ft. and in. to ft.

WELL WATER TO BE USED AS: 5 Public water supply 8 Air conditioning 11 Injection well

1 Domestic 3 Feedlot 6 Oil field water supply 9 Dewatering 12 Other (Specify below)

2 Irrigation 4 Industrial 7 Lawn and garden only 10 Monitoring well

Was a chemical/bacteriological sample submitted to Department? Yes No X; If yes, mo/day/yr sample was submitted

Water Well Disinfected? Yes No

5 TYPE OF BLANK CASING USED:

1 Steel

3 RMP (SR)

5 Wrought iron

8 Concrete tile

CASING JOINTS: Glued Clamped

2 PVC

4 ABS

6 Asbestos-Cement

9 Other (specify below)

Welded

Blank casing diameter 2.375 in. to 10' ft. Dia in. to ft. Dia in. to SDR 1.3ft.

Casing height above land surface Fresh Mt. in., weight lbs./ft. Wall thickness or gauge No. Sch. 40

TYPE OF SCREEN OR PERFORATION MATERIAL:

1 Steel

3 Stainless steel

5 Fiberglass

7 PVC

10 Asbestos-cement

2 Brass

4 Galvanized steel

6 Concrete tile

8 RMP (SR)

11 Other (specify)

12 None used (open hole)

SCREEN OR PERFORATION OPENINGS ARE:

1 Continuous slot

3 Mill slot

5 Gauzed wrapped

8 Saw cut

11 None (open hole)

2 Louvered shutter

4 Key punched

6 Wire wrapped

9 Drilled holes

7 Torch cut

10 Other (specify)

SCREEN-PERFORATED INTERVALS: From 20' ft. to 10' ft. From ft. to ft.

From ft. to ft. From ft. to ft.

GRAVEL PACK INTERVALS: From 20'6" ft. to 8' ft. From ft. to ft.

From ft. to ft. From ft. to ft.

6 GROUT MATERIAL:

1 Neat cement

2 Cement grout

3 Bentonite

4 Other

Grout Intervals: From 8' ft. to 4' ft. From 4' ft. to 0' ft. From ft. to ft.

What is the nearest source of possible contamination:

1 Septic tank

4 Lateral lines

7 Pit privy

10 Livestock pens

14 Abandoned water well

2 Sewer lines

5 Cess pool

8 Sewage lagoon

11 Fuel storage FOUER

15 Oil well/Gas well

3 Watertight sewer lines

6 Seepage pit

9 Feedyard

12 Fertilizer storage

16 Other (specify below)

13 Insecticide storage

Direction from well? In Tank Pit

How many feet? 0'

FROM	TO	LITHOLOGIC LOG	FROM	TO	PLUGGING INTERVALS
0	1	Gravel-roadbase			
1	3.50	Dk brn silty sand to sandy silt, soft, no odor, dry.			
3.50	6.50	Med to lt brn sandy silt to silty clay, moist, no odor, oxide staining, fine grained sand.			
6.50	11.25	Fine-med grains sand, dry, loose.			
11.25	17	Fine-coarse grained sand & gravel, wet, strong odor.			
17	19	Gray silt, moist to wet, soft.			
19	20'6"	Fine grained white sand, wet, no odor.			

F.H. OK'd by Don Taylor

7 CONTRACTOR'S OR LANDOWNER'S CERTIFICATION: This water well was (1) constructed (2) reconstructed, or (3) plugged under my jurisdiction and was completed on (mo/day/year) 4-18-96 and this record is true to the best of my knowledge and belief. Kansas

Water Well Contractor's License No. 539 This Water Well Record was completed on (mo/day/yr) 5-23-96

under the business name of JB Environmental Drilling by (signature) James Becker